



AS-INSTALLED FRONT ELEVATION

Scale 1:50

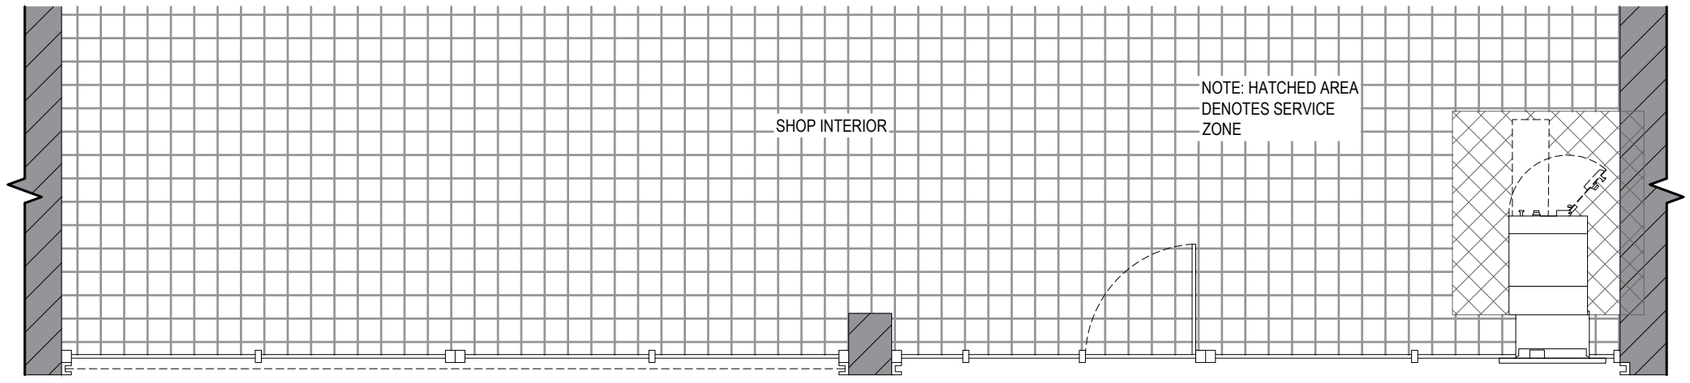

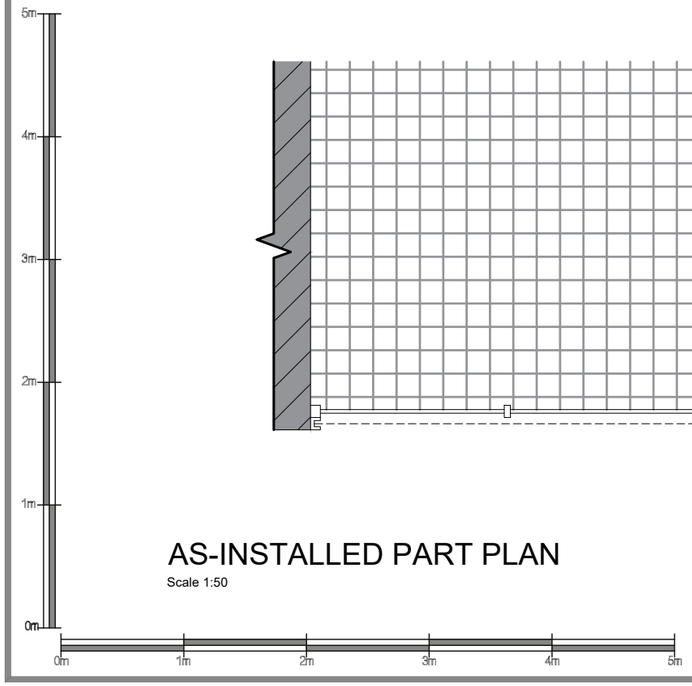

AS-INSTALLED PART PLAN

Scale 1:50

Date:	Comments:	By:

GENERAL NOTES:

1) All dimensions in millimeters unless otherwise stated.

Site:
Aisha News & Groceries,
5-6 Argyle Parade,
Heywood

Drawing Title:
As-Installed Plan and Elevation

Ref:	Date: 04/01/2019	Rev:
Scale: 1:50	Paper: A3	Date Rev: