
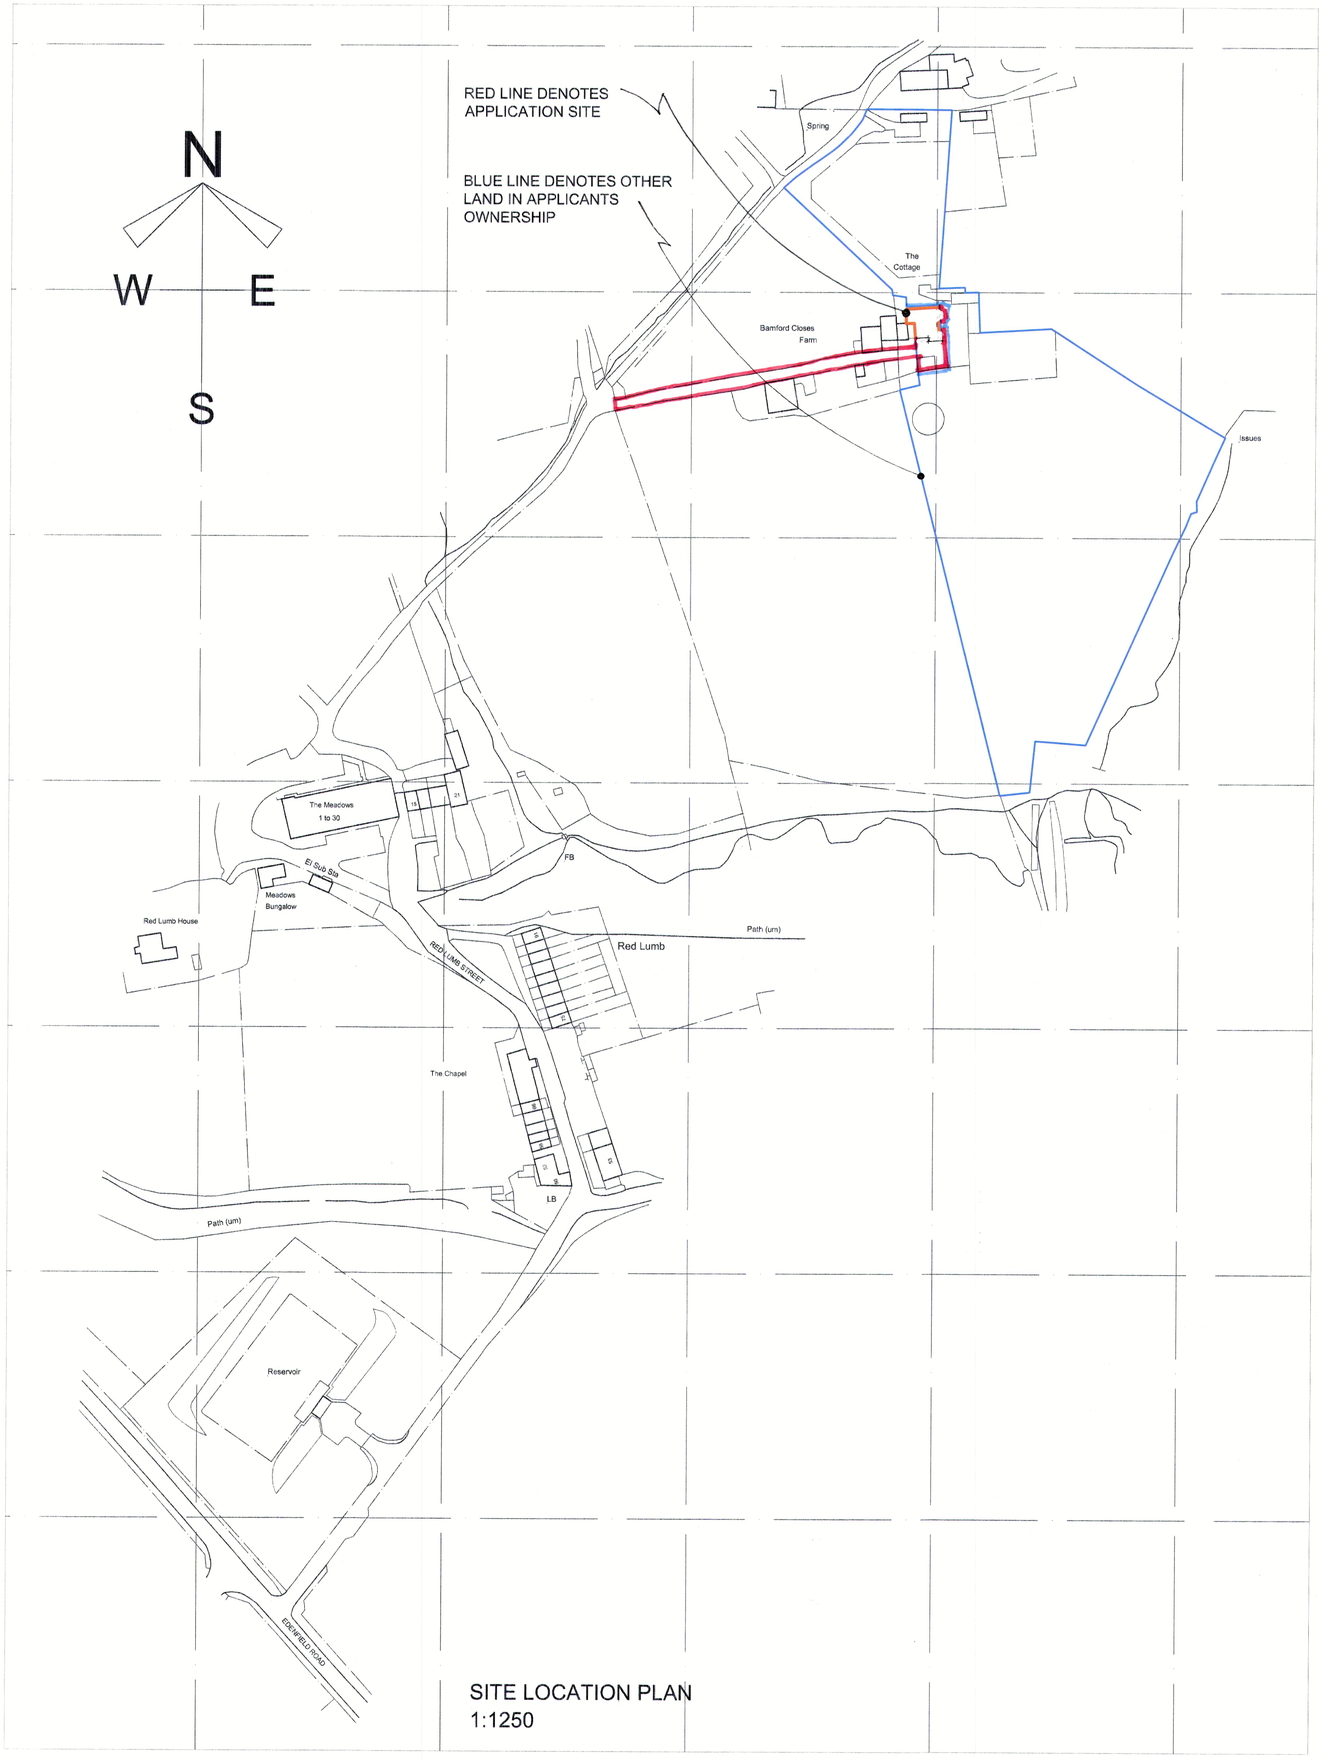


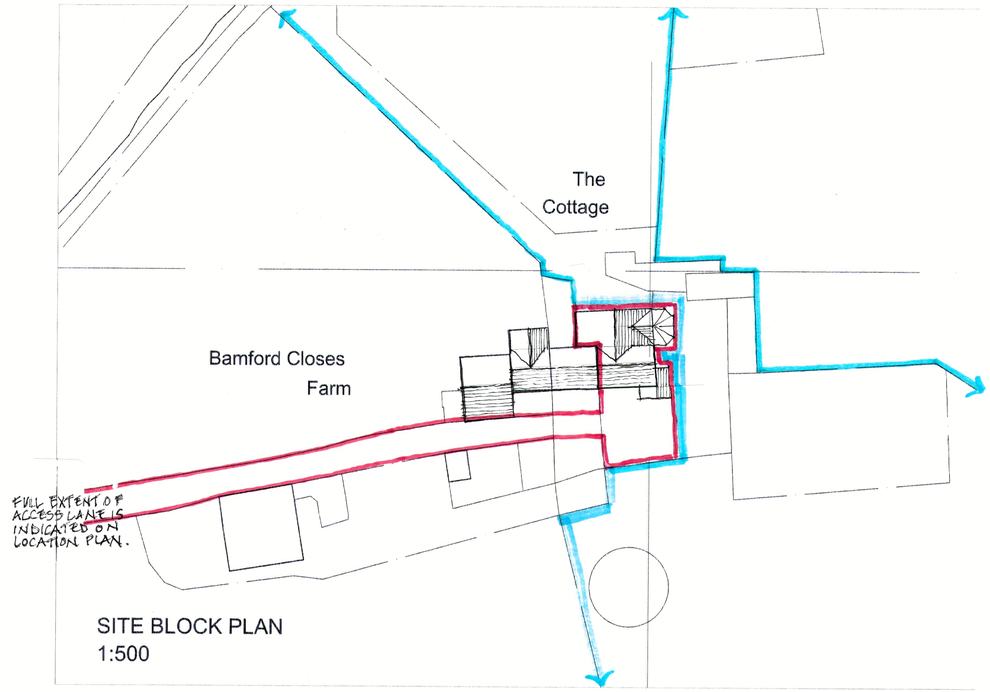

REV A. "RED LINE" AMENDED 30TH 04-2019.

Project
THE BARN. BAMFORD CLOSES FARM. RED LUMB - OL12, 7TX.

Title
SITE LOCATION & BLOCK PLAN.

Scale	Date
1-1250 & 1:500	MARCH 2019
Dwg No	Drawn
4826-1.A	MT.

Bury Office.
3 Manchester Road
Bury
BL9 0DR

Tel : 0161 764 6995
email : mt@gandw.co.uk

GREENHALGH and WILLIAMS

Architects and Building Surveyors