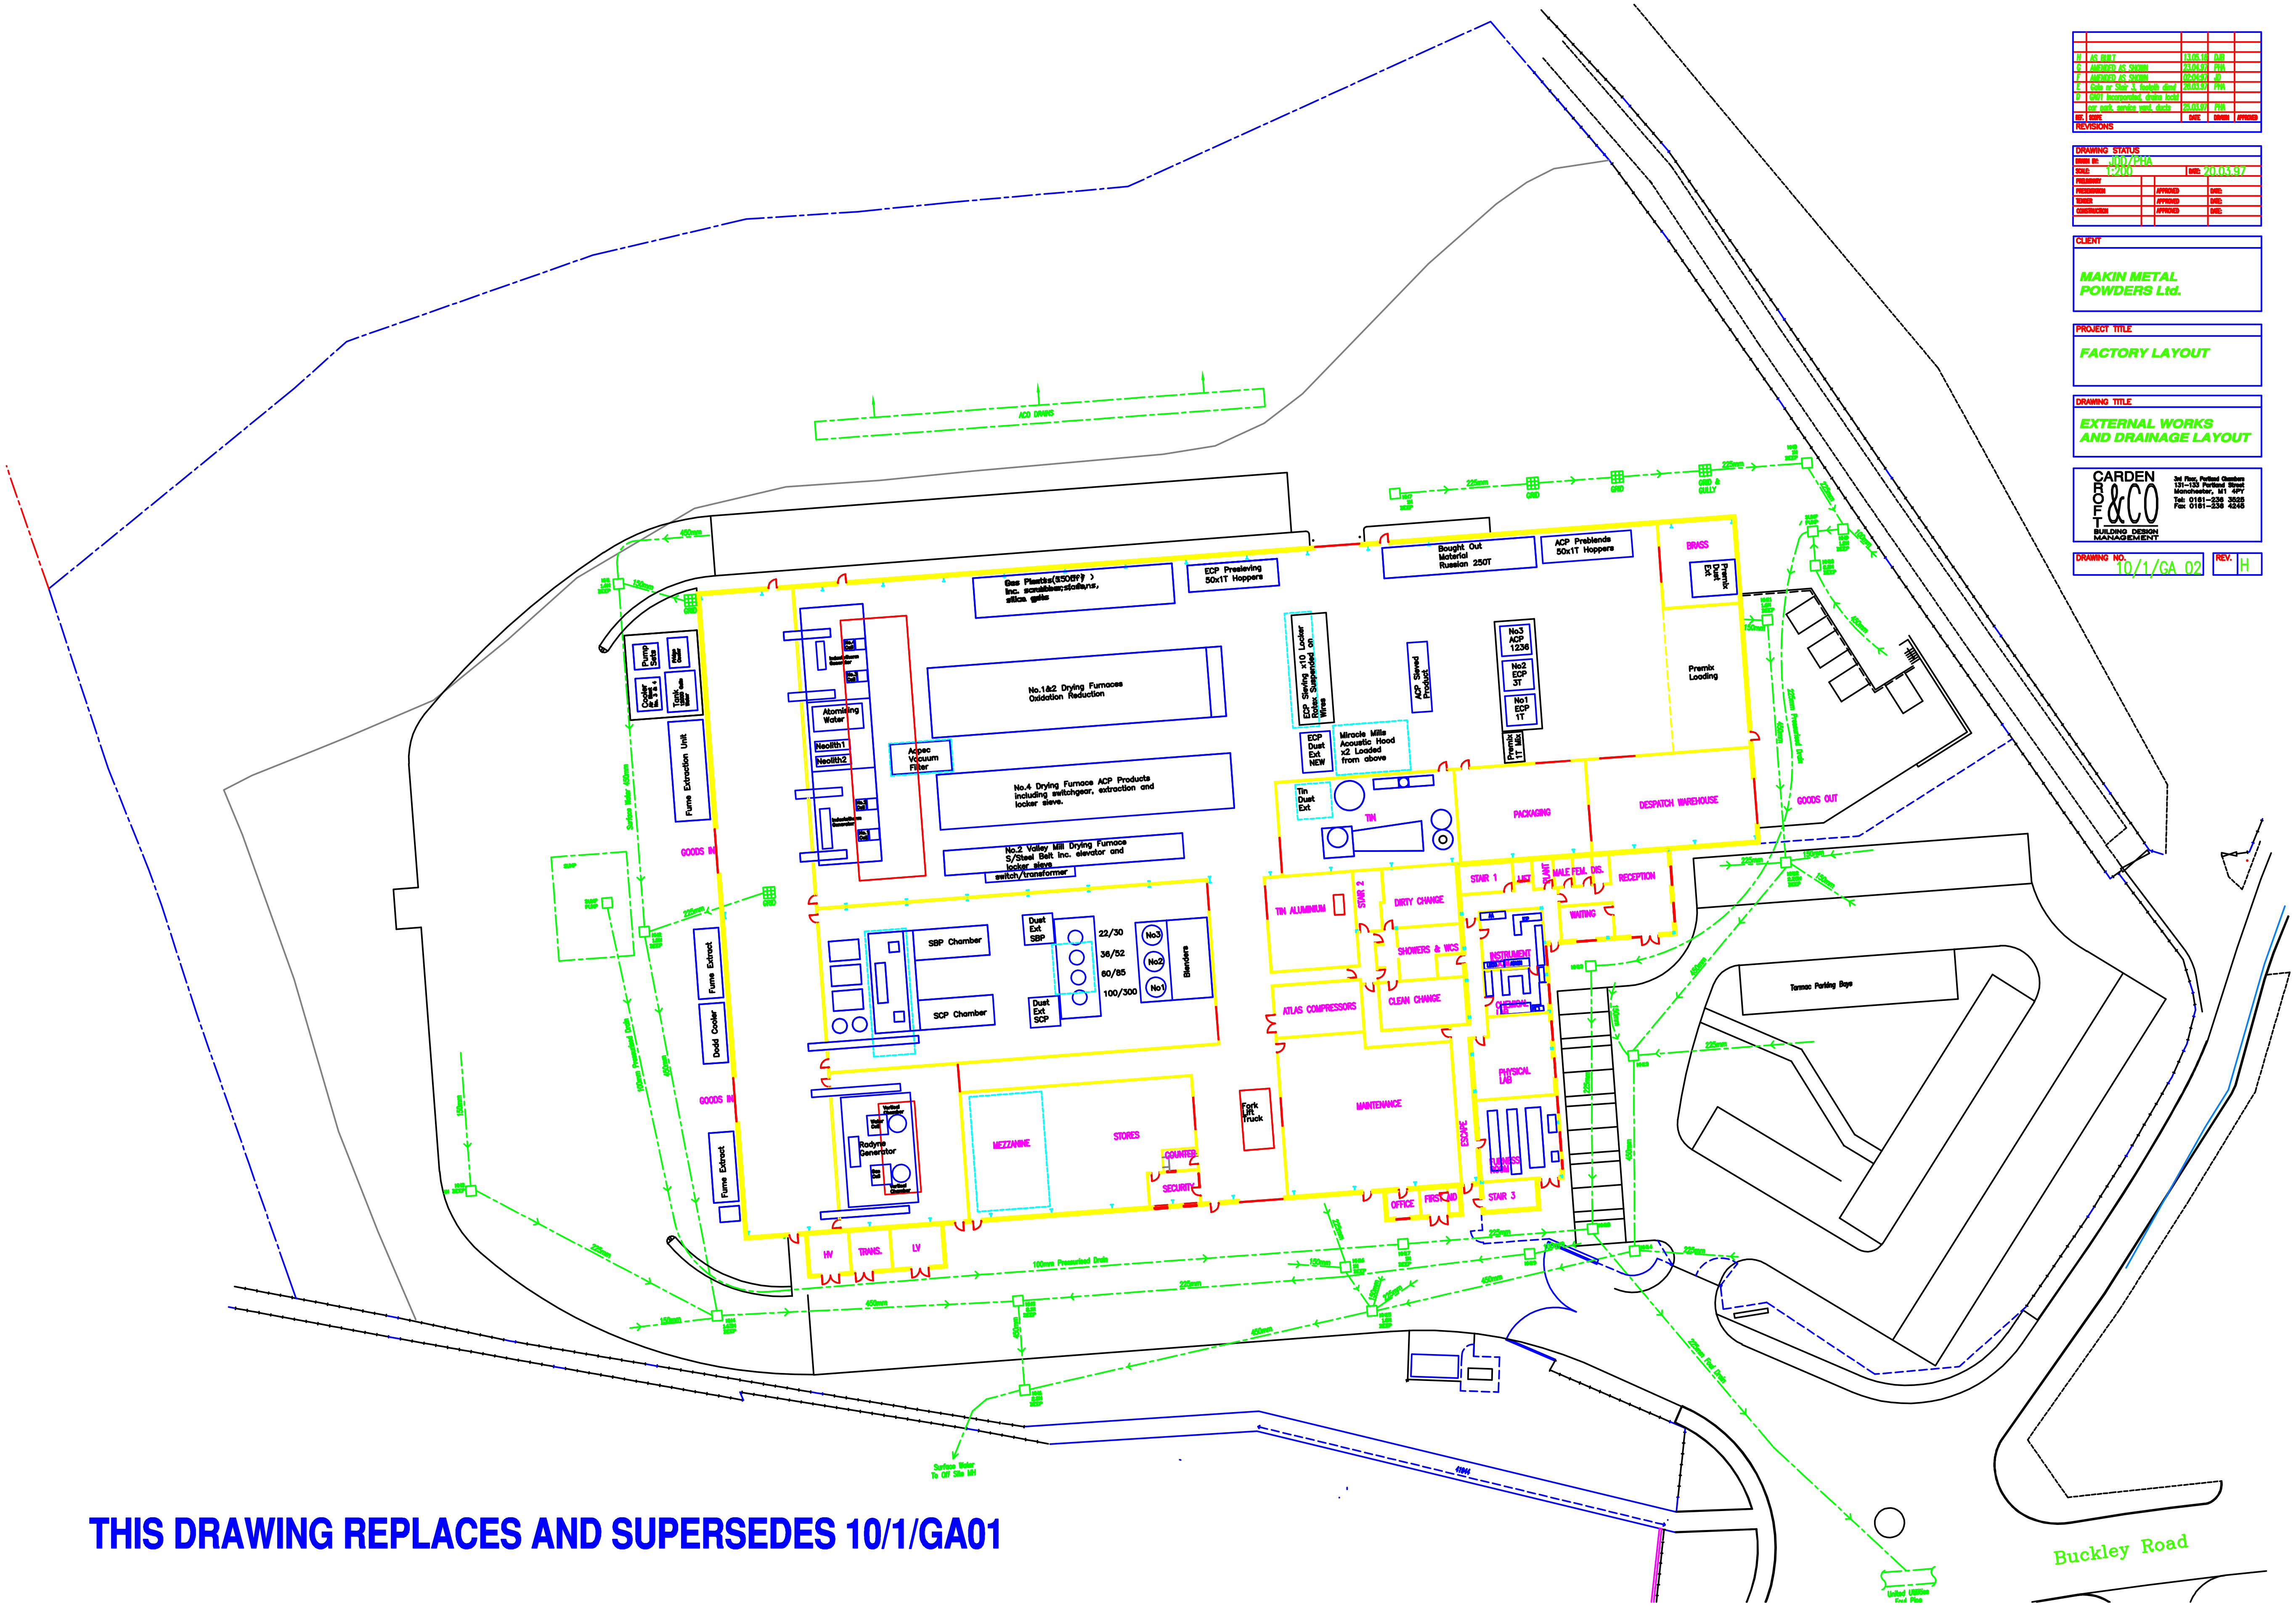

THIS DRAWING REPLACES AND SUPERSEDES 10/1/GA01

REF.	SCOPE	DATE	DRAWN	APPROVED
H	AS BUILT	13.05.18	DJB	
G	AMENDED AS SHOWN	23.04.97	PHA	
F	AMENDED AS SHOWN	02.04.97	JD	
E	Gate nr Stair 3, footpth dimd	26.03.97	PHA	
D	GA01 Incorporated, drains loctd car park, service yard, ducts	25.03.97	PHA	

REVISIONS

DRAWING STATUS

DRAWN BY: JDD/PHA			
SCALE: 1:200			DATE: 20.03.97
PRELIMINARY			
PRESENTATION		APPROVED	DATE:
TENDER		APPROVED	DATE:
CONSTRUCTION		APPROVED	DATE:

CLIENT

MAKIN METAL POWDERS Ltd.

PROJECT TITLE

FACTORY LAYOUT

DRAWING TITLE

EXTERNAL WORKS AND DRAINAGE LAYOUT

CARDEN CROFT &CO
BUILDING DESIGN MANAGEMENT

3rd Floor, Portland Chambers
131–133 Portland Street
Manchester, M1 4PY
Tel: 0161–236 3525
Fax 0161–236 4245

DRAWING NO. 10/1/GA 02

REV. H