0m 50m 100m 150m 200m 250m

VISUAL SCALE 1:2500

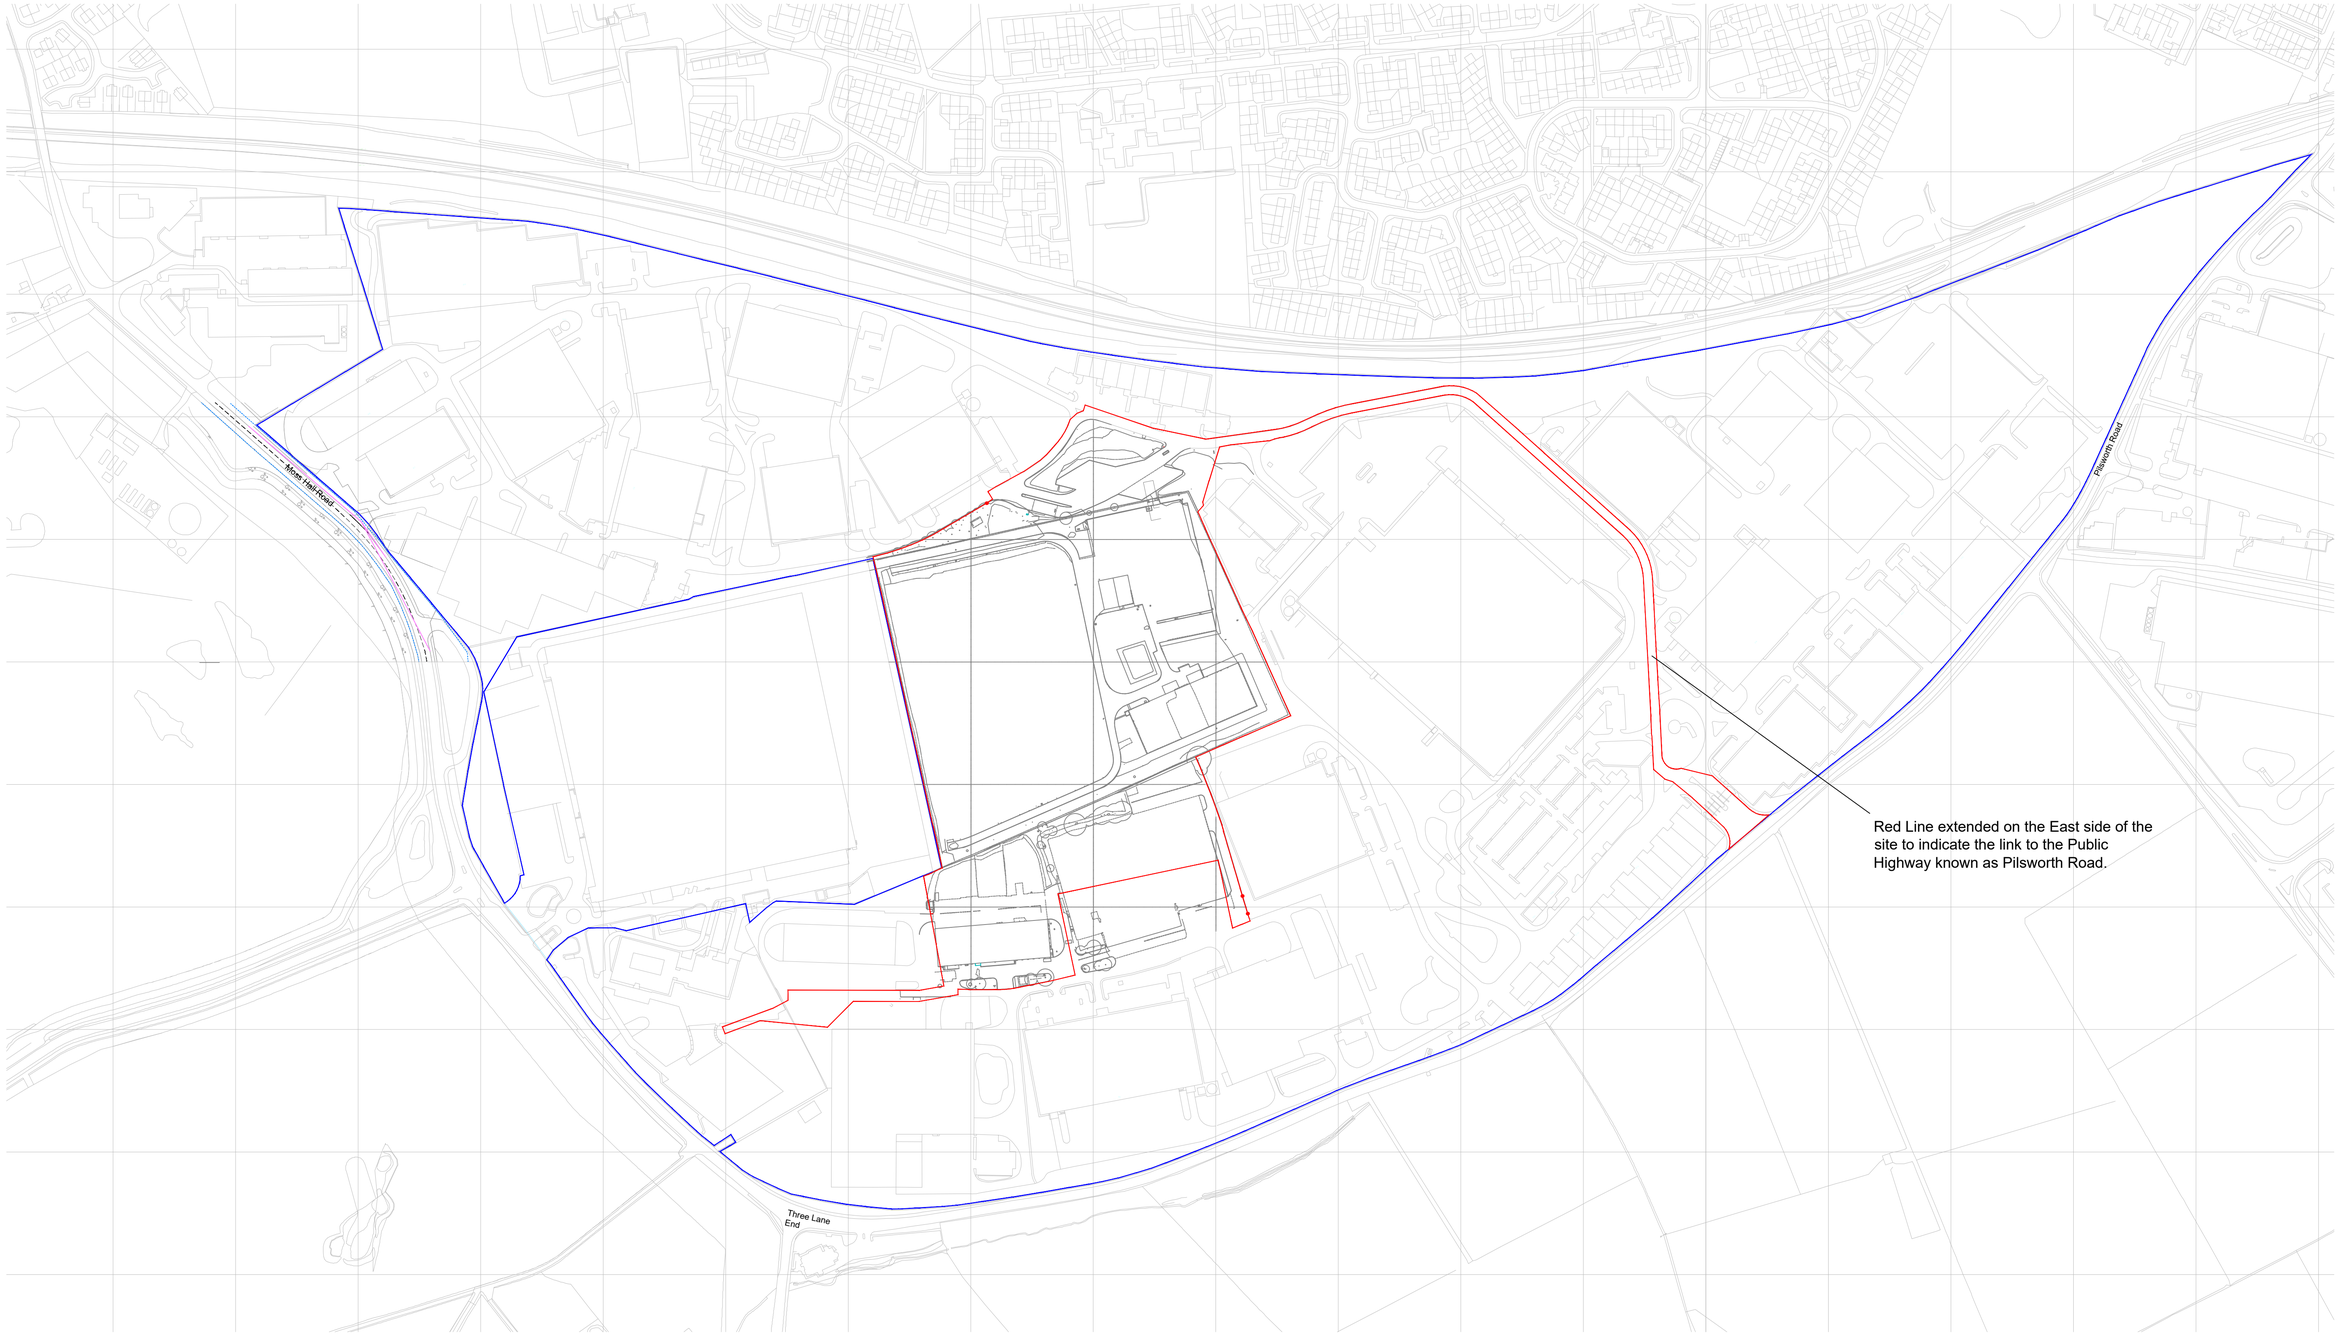

Red Line extended on the East side of the site to indicate the link to the Public Highway known as Pilsworth Road.

1 Site Plan
1 : 2500

Do not scale this drawing
ashton smith to be notified of discrepancies in figured dimensions
Contractors must check all dimensions from site
This drawing is copyright and is for use on this site only
This drawing is to be used solely for information as entitled
For other information refer to the latest revision of any cross referenced drawing

LOCATION PLAN:

NOTES:

Planning Application Boundary
24.878 Acres (10.068 Hectares)

Ownership Boundary

REV	DATE	DESCRIPTION	DRAWN BY	CHECK BY
P2	17/05/22	Red Line extended on the East side of the site to indicate the link to the Public Highway known as Pilsworth Road.	NJB	RB
P1	31/03/22	Pre Planning Issue	NJB	RB

REVISIONS

PROJECT TITLE
M400, HEYWOOD MANCHESTER

DRAWING TITLE
Site Location Plan

RIBA STAGE	STATUS		DRAWN BY	CHECKED BY
3	PLANNING		NJB	RB
SHEET	SCALE	DATE	SUITABILITY	REVISION
A1	1 : 2500	04/05/22	S0	P2

DRAWING NO.
HDP1 - ASA - 00 - EX.SI - D - A - 0040 _ (S0 - P2)

CLIENT

AshtonSmith
Beyond Design
Ashton Smith, Belvedere House, 2 Victoria Avenue, Harrogate, North Yorkshire, HG1 1EL
Tel: 01423 522882 Fax: 01423 565104
www.ashtonsmith.co.uk

JOB NO. 20132