

COPYRIGHT RESERVED.
This drawing is the property of A.J.Cocker Associates and must not be copied or used in whole or in part without their consent.


CDM:
Clients and contractors must fulfil their duties under the CDM regulations 2015.The client is required to notify the HSE of any projects lasting more than 30 days or involving more than 500 person days.

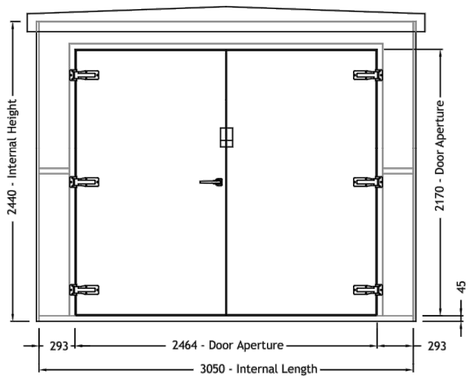


FRONT ELEVATION

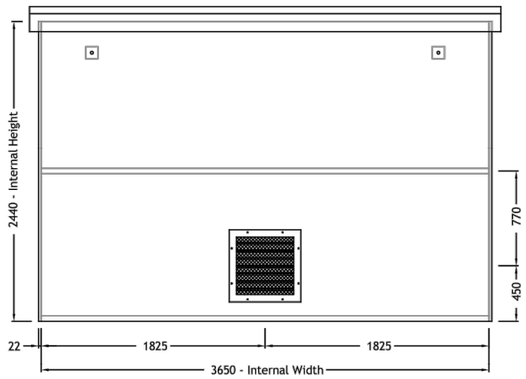



RH & LH SIDE ELEVATIONS

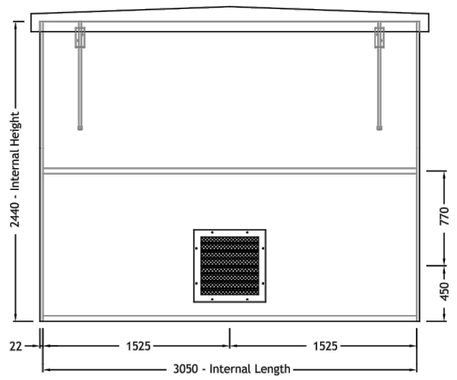


REAR ELEVATION

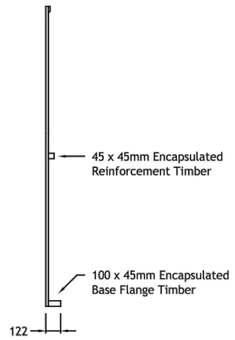

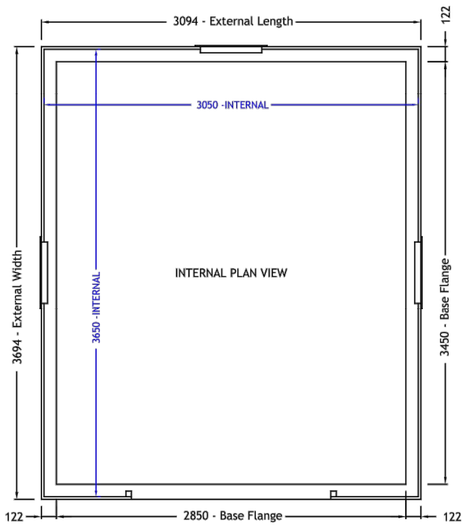

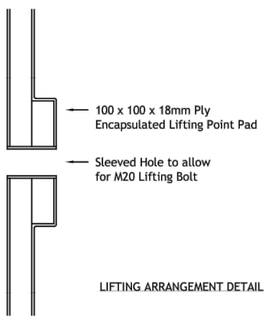

LIFTING ARRANGEMENT DETAIL

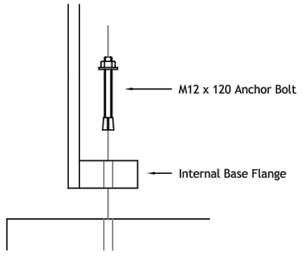

GROUND FIXING DETAIL

Dimensions:	3650 x 3050 x 2440mm (Internal)
Finish:	~~External - Textured 14 C 39 British Racing Green~~ ~~Colour - 14 C 39 British Racing Green~~ Internal - White Resin Flocoat
Doors:	1 Set of Double Doors - 1220mm x 2150mm Colour - 14 C 39 British Racing Green- LH opening
Lock Type:	3 Way Locking c/w S/S Padlockable L Handle UU Hasp & Staple
Vents:	3 off 500 x 500 Vents, Positioned Low Level
Roof Type:	Explosion Relief. Colour - 14 C 39 c/w 50mm Soffit Ventilation
Extras:	None

Details supplied by Kingsley Plastics Limited for GRP heavy duty kiosk



External wall finish to be brick effect - not green as specified.

Proposed sub station - see drawing number H332/021 for location on site

AJ COCKER ASSOCIATES
CHARTERED BUILDING SURVEYORS
New Century House
176 Drake Street
Rochdale
OL16 1UP
Tel: 01706 764880
Fax: 01706 764881
www.ajcockerassociates.co.uk
mail@ajcockerassociates.co.uk

RICS the mark of property professionalism worldwide

project
Coldwall Industrial Estate
Spotland Road, Rochdale

client
Hallmark Developments

scale - 1:50
size - A3
date - Feb. 21
drawn - NL

drawing No H332/030

rev