This drawing is provided as a document to gain either Planning Permission or Building Regulation approval purposes only. It is not a guarantee that Planning Permission will be granted.

This drawing and all contents are the copyright of James Campbell Associates Ltd. No copies to be made from the drawing & details within unless authorised by James Campbell Associates Ltd.

The contract for the works is between the client and his / her contractor. Contractor to visit site, study the details provided within the drawing and be familiar with both the work to be carried out in accordance with the details provided. Any stated dimension must be checked prior to any form of construction. All works and materials to comply with all relevant British Standards and carry a genuine BBA certificate. The materials specified within this drawing are a guide for the contractor as they are recognised materials with genuine BBA certificates etc. Any contractor who decides to use any different materials than that noted on the drawing must inform James Campbell Associates Ltd.

Any discrepancies discovered or items found that where not visible at the time of the initial survey should be reported to James Campbell Associates Ltd for consultation with our client.

CONSTRUCTION NOTES:-



AS BUILT SITE PLAN

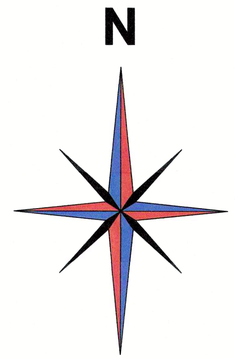

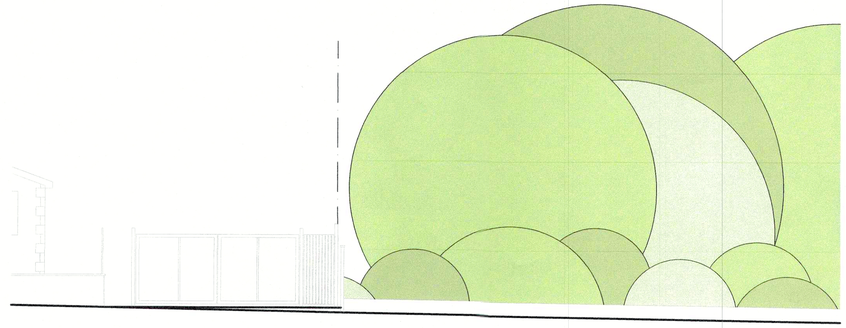

AS BUILT TODMORDEN ROAD ELEVATION
1:100

AS BUILT FENCE DETAIL A - PLAN
1:50



AS BUILT FENCE DETAIL A - ELEVATION
1:100

RUBBLE AND SOIL IN FILLED AREA
NEW LEVELS

HARDCORE ENTRANCE ROAD

BANKING REMOVED

NEW TIMBER FENCING (See Fence Detail A)

DRAWING TITLE
AS BUILT SITE PLAN

JAMES CAMPBELL ASSOCIATES LTD
CHARTERED ARCHITECTURAL SERVICES
CIOB
CIAT
Campbell House
173 Rochdale Road
Firgrove
Rochdale
OL16 3BN
Tel: 01706 354888
Mob: 07817 623183
Email: admin@jamescampbellassociates.co.uk
Web: www.jamescampbellassociates.co.uk

PROJECT
PROPOSED RETROSPECTIVE WORKS

LOCATION
Land off Todmorden Road Littleborough

DRAWN:-	Frank James Smith	DRAWING NUMBER:-
DATE:-	August 2019	19.1973.3A
SCALE:-	1:250 at A1	
ISSUE:-	A	

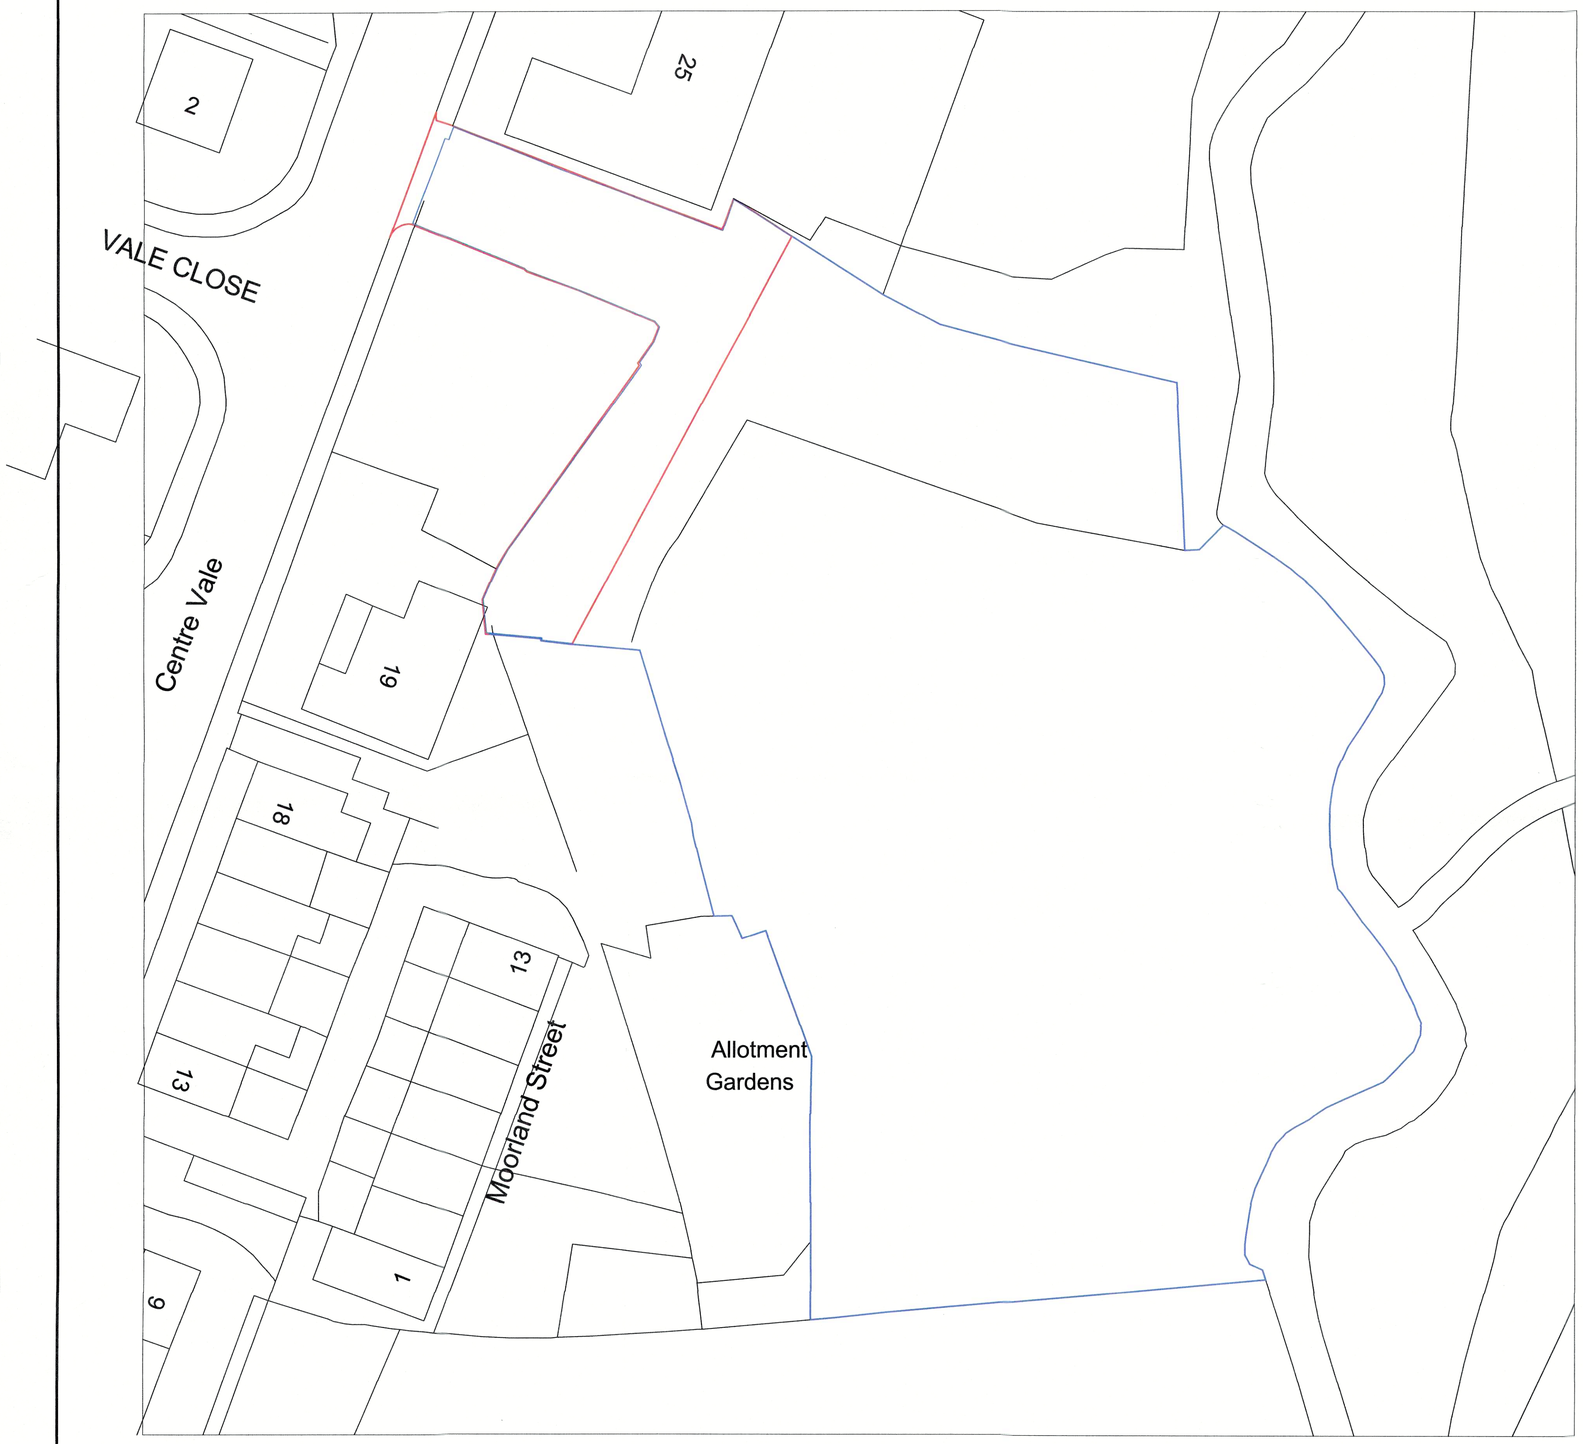

EXISTING SITE PLAN

This drawing is provided as a document to gain either Planning Permission or Building Regulation approval purposes only. It is not a guarantee that Planning Permission will be granted.

This drawing and all contents are the copyright of James Campbell Associates Ltd. No copies to be made from the drawing & details within unless authorised by James Campbell Associates Ltd.

The contract for the works is between the client and his / her contractor. Contractor to visit site, study the details provided within the drawing and be familiar with both the work to be carried out in accordance with the details provided. Any stated dimension must be checked prior to any form of construction. All works and materials to comply with all relevant British Standards and carry a genuine BBA certificate. The materials specified within this drawing are a guide for the contractor as they are recognised materials with genuine BBA certificates etc. Any contractor who decides to use any different materials than that noted on the drawing must inform James Campbell Associates Ltd.

Any discrepancies discovered or items found that where not visible at the time of the initial survey should be reported to James Campbell Associates Ltd for consultation with our client.

CONSTRUCTION NOTES:-

N

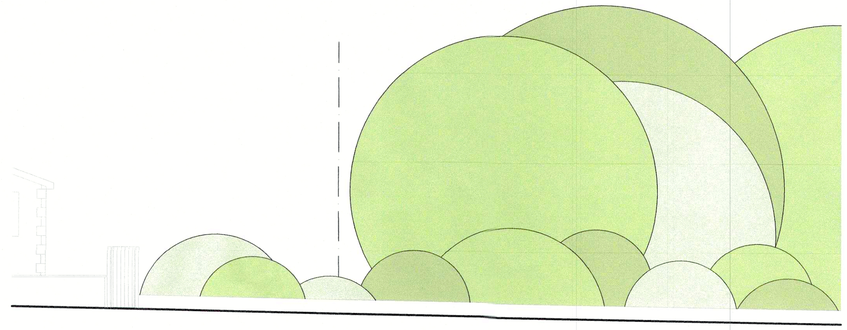

EXISTING TODMORDEN ROAD ELEVATION

DRAWING TITLE

EXISTING SITE PLAN

JAMES CAMPBELL ASSOCIATES LTD
CHARTERED ARCHITECTURAL SERVICES
CIOB
CIAT

Campbell House
173 Rochdale Road
Firgrove
Rochdale
OL16 3BN

Tel: 01706 354888
Mob: 07817 623183
Email: admin@jamescampbellassociates.co.uk
Web: www.jamescampbellassociates.co.uk

PROJECT

PROPOSED RETROSPECTIVE WORKS

LOCATION

**Land off Todmorden Road
Littleborough**

DRAWN:-	Frank James Smith	DRAWING NUMBER:-
DATE:-	August 2019	19.1973.1B
SCALE:-	1:250 at A1	
ISSUE:-	B	

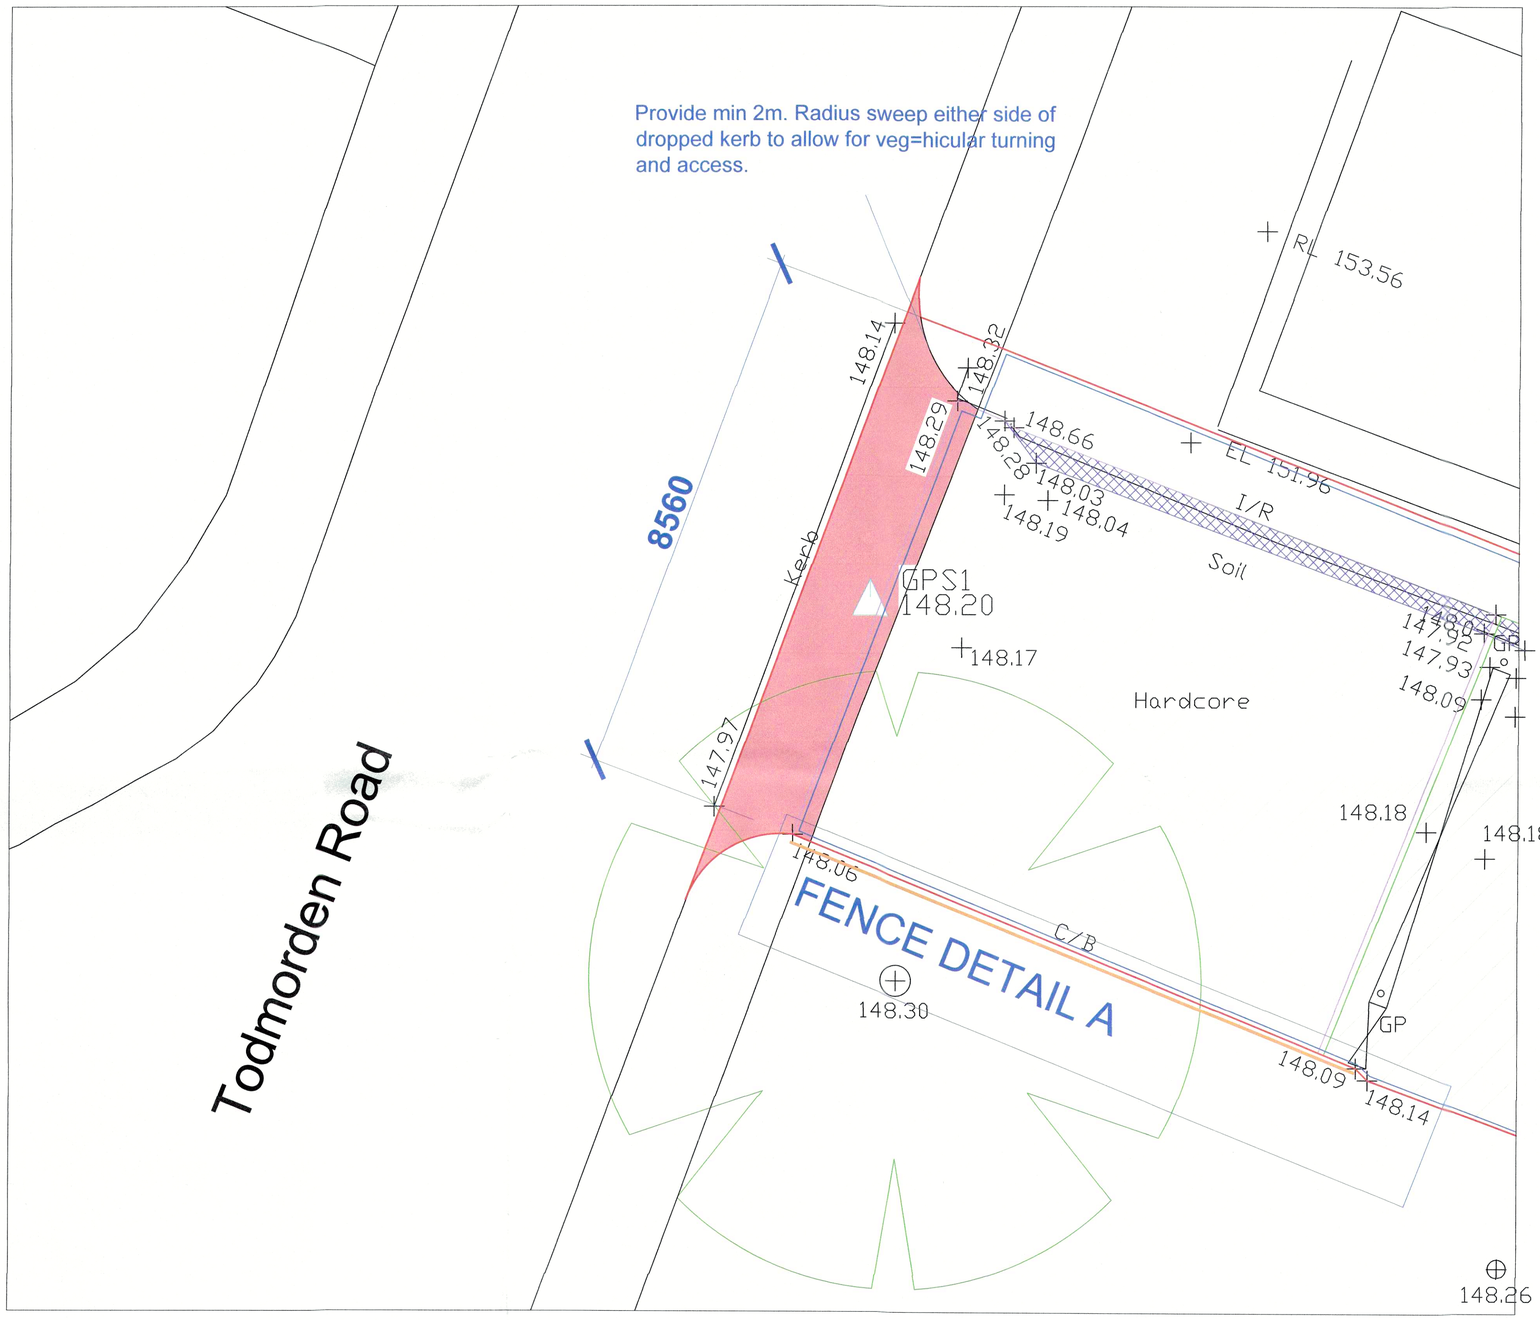

PROPOSED ROAD DETAILS

HARDCORE ENTRANCE ROAD

PROPOSED DROPPED KERB
NEW LEVELS

This drawing is provided as a document to gain either Planning Permission or Building Regulation approval purposes only. It is not a guarantee that Planning Permission will be granted.

This drawing and all contents are the copyright of James Campbell Associates Ltd. No copies to be made from the drawing & details within unless authorised by James Campbell Associates Ltd.

The contract for the works is between the client and his / her contractor. Contractor to visit site, study the details provided within the drawing and be familiar with both the work to be carried out in accordance with the details provided. Any stated dimension must be checked prior to any form of construction. All works and materials to comply with all relevant British Standards and carry a genuine BBA certificate. The materials specified within this drawing are a guide for the contractor as they are recognised materials with genuine BBA certificates etc. Any contractor who decides to use any different materials than that noted on the drawing must inform James Campbell Associates Ltd.

Any discrepancies discovered or items found that where not visible at the time of the initial survey should be reported to James Campbell Associates Ltd for consultation with our client.

CONSTRUCTION NOTES:-

DRAWING TITLE
PROPOSED ROAD DETAILS

JAMES CAMPBELL ASSOCIATES LTD
CHARTERED ARCHITECTURAL SERVICES
CIOB
CIAT
Campbell House
173 Rochdale Road
Firgrove
Rochdale
OL16 3BN
Tel: 01706 354888
Mob: 07817 623183
Email: admin@jamescampbellassociates.co.uk
Web: www.jamescampbellassociates.co.uk

PROJECT
PROPOSED RETROSPECTIVE WORKS

LOCATION
Land off Todmorden Road
Littleborough

DRAWN:-	Frank James Smith	DRAWING NUMBER:-
DATE:-	August 2019	19.1973.5
SCALE:-	1:50 at A1	
ISSUE:-		


VALE CLOSE
Todmorden Road
Centre Vale
Moorland Street
Allotment Gardens
25
21
19
18
13
13
1
9
FENCE DETAIL A
Hardcore
Grass
Bird Cage
Summerhouse
Borehole Cap
Top Of Cap
Bottom of Bank
Top of Bank
Top of Bank
Bottom of Bank
Top of Bank
Bottom of Bank
Top of Bank
Top of Bank
Bottom of Bank
Top of Bank
Top of Bank
Bottom of Bank
Top