

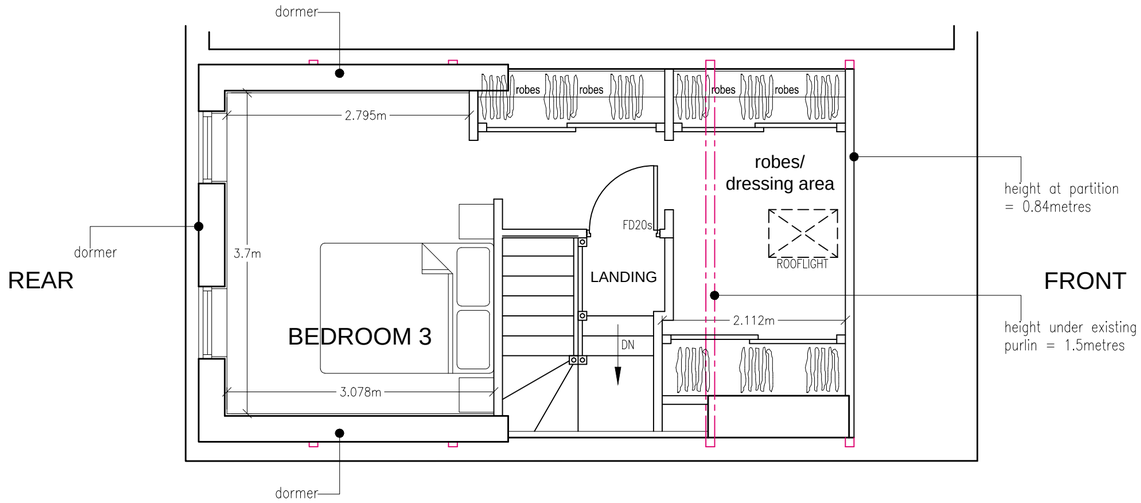



PROPOSED ATTIC FLOOR PLAN (1:50)

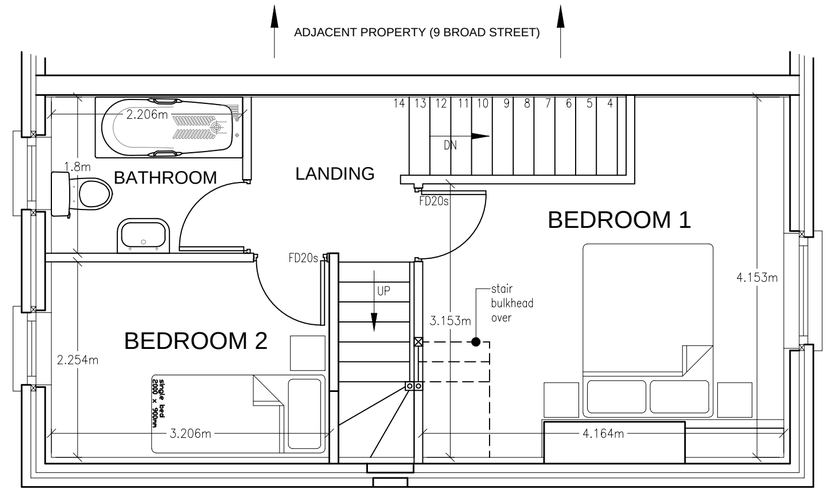

PROPOSED FIRST FLOOR PLAN (1:50)

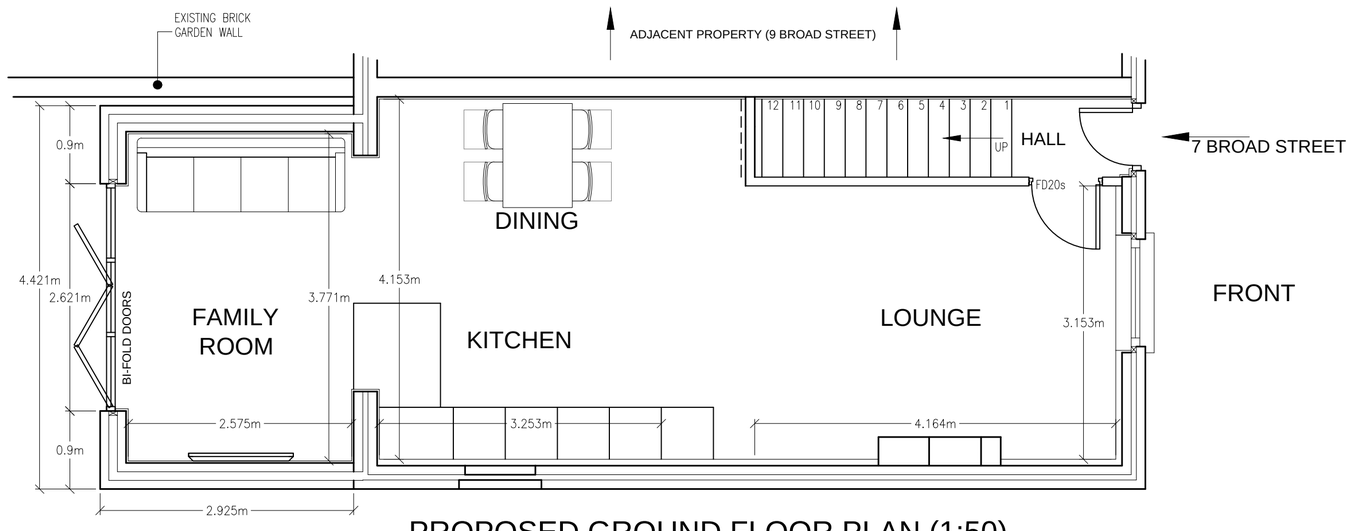

PROPOSED GROUND FLOOR PLAN (1:50)

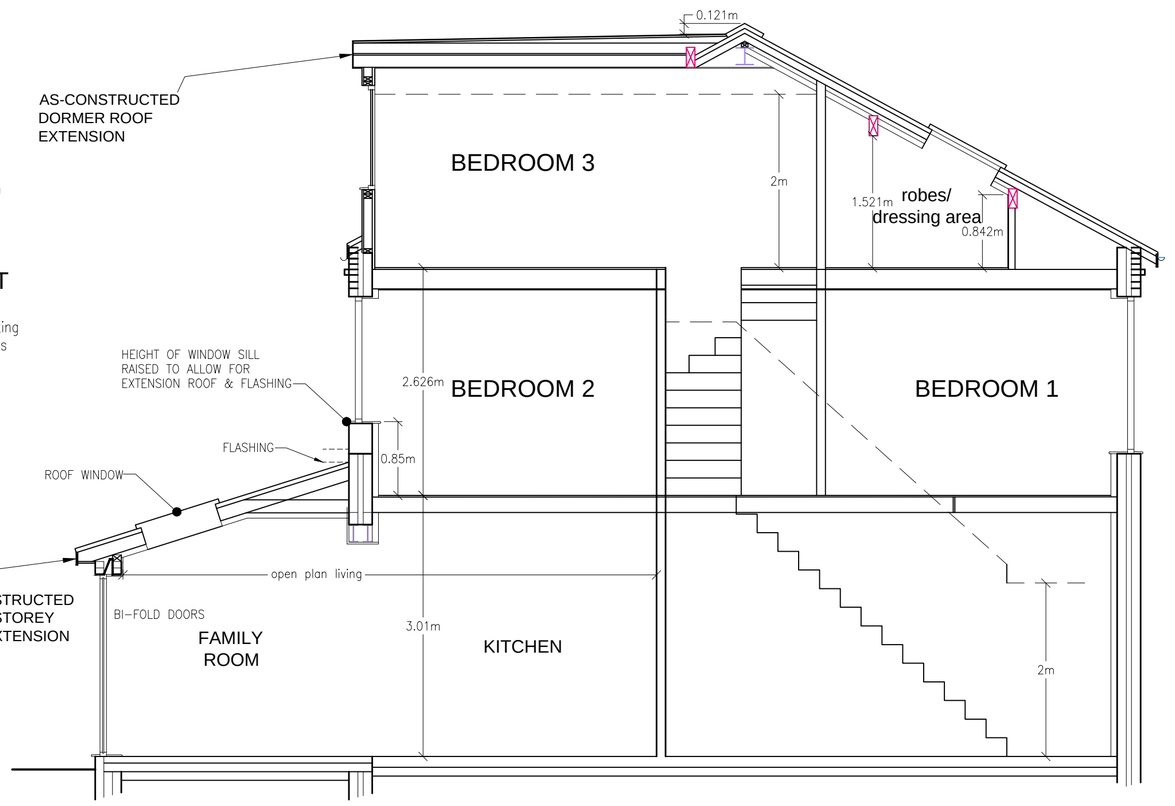

PROPOSED DESIGN SECTION (1:50)

NOTES;

A	11.11.19	JPE	PLANS UPDATED TO SHOW AS-CONSTRUCTED DORMER AND WINDOW POSITIONS.

Amendments

Title

AS-CONSTRUCTED SINGLE STOREY EXTENSION TO REAR AND CONVERSION OF ROOF SPACE WITH DORMER ROOF, AT 7 BROAD STREET, MIDDLETON~

Client

MR R. HUGHES

Dwg. No.

18/1204/201A – PROPOSED FLOOR PLANS

Date	*Plot Scale*	*Drawn by*	*Status*
29.11.2018	A2@1:50	JPE	ISSUE

JPE CONSULTANCY LIMITED
ARCHITECTURAL DESIGN & PLANNING
9 Woodend Drive, Stalybridge, Cheshire, SK15 2SF
Telephone 07875 627 988 jim@jpeconsultancy.co.uk