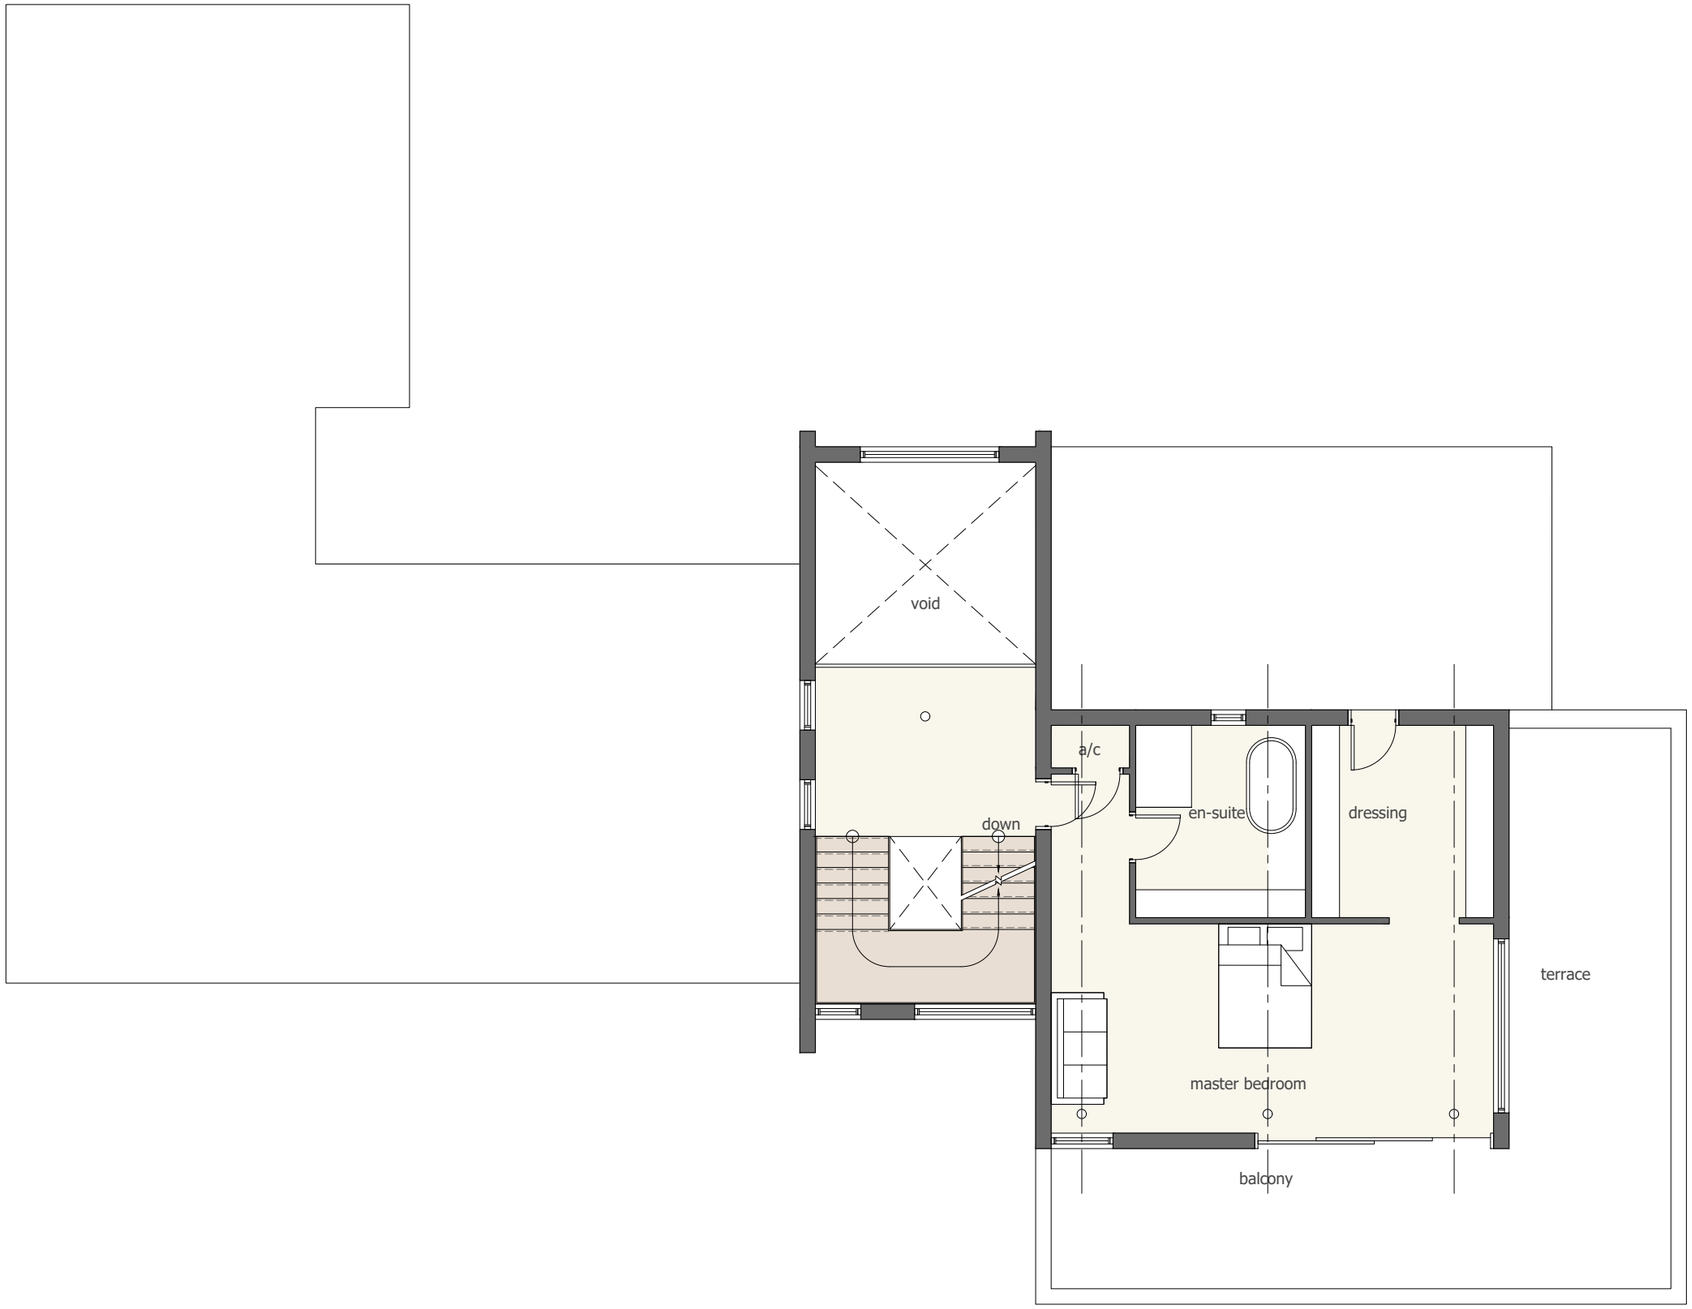


first floor plan

Kieren and Jo McDonnell Proposed Eco Home Mill House Farm Overtown Lane Norden	First Floor Plan **AS BUILT** work to figured dimensions © CJ Partnership owns the copyright of this design / drawing which must not be reproduced in whole or in part without the written permission of CJ Partnership	contract no 3396 drawn by PDC	drawing no 17 date May 202	revision scale @ A3 1:100	Revisions: A.	Blue Pit Mill Queensway Castleton Rochdale OL11 2PG +44 (0)1706 631347 info@cjpartnership.com www.cjpartnership.com	CJPARTNERSHIP ENVIRONMENTAL ARCHITECTS