


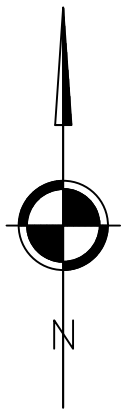


BENCH MARK INFORMATION

ALL LEVELS ARE RELATED TO O.S DATUM (OSGB36-15)
ESTABLISHED AT SE1 USING THE LEICA SMARTNET GPS NETWORK



PRIVATE DRAINAGE

All private drainage is to comply with Part H of the Building Regulations.
Where a drain run is to be excavated lower than the foundations of any building and the trench is within 1m of the foundation the trench is to be filled with concrete up to the lowest level of the foundation or where the trench is further than 1m from the building, the trench is filled with concrete to a level below the lowest level for the building equal to the distance from the building less 150mm (refer to diagram 8).

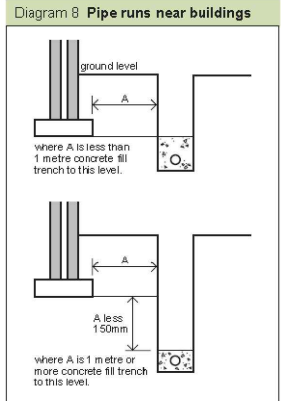

All private drainage to be 110mm # unless indicated otherwise. Draught manhole sizes to be in accordance with table 11 & 12 in the above document.

Gradients
Foul water -110mm. diam. -1 in 80 minimum (min. of 1 W.C. connected)
Foul water -150mm. diam. -1 in 150 minimum (min. of 5 W.C.'s connected)
Surface water -110mm. diam. -1 in 100 minimum
Surface water -150mm. diam. -1 in 150 minimum
Surface water -225mm. diam. -1 in 225 minimum

Levels
(10.00) denotes a foul water invert level.
(10.00) denotes a surface water invert level.

UNIVERSAL ACCESS SYSTEM (Hepworth Building products)

SDM21/1

Mini Access Chamber (max.600mm. deep by 300mm int.diameter)
(Inlet / Outlet diameters 100/110)

SPIC6/1
Polypropylene Inspection Chamber PPC (max.1200mm. deep by 475mm int.diameter)
(Inlet diameters 100/110/150/160 Outlet 100/110)

SPIC6/2
Polypropylene Inspection Chamber PPC (max.1200mm. deep by 475mm int.diameter)
(Inlet diameters 100/110/150/160 Outlet 150/160)

SPIC1/1
Reduced access Telescopic PPC (1.2m - 3.0m deep by 475mm int.diameter)
(Inlet diameters 100/110/150/160 Outlet 100/110)


SPIC1/2
Reduced access Telescopic PPC (1.2m - 3.0m deep by 475mm int.diameter)
(Inlet diameters 100/110/150/160 Outlet 150/160)

Foul Water / Combined Water Drain (private)

Surface Water Drain (private)

Rodding Point

PLEASE REFER TO LATEST REVISION OF HOUSE TYPE WORKING DRAWINGS FOR EXACT LOCATIONS OF DRAINAGE PICK UP POINTS.
PLEASE REPORT ANY DISCREPANCY TO REFA BEFORE COMMENCING CONSTRUCTION.

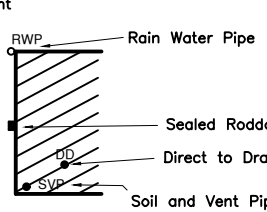

PLEASE NOTE
ALL HOUSE ROOF AND DRIVEWAY RAIN WATER GULLIES ARE TO BE TRAPPED.

EXISTING SEWER TO BE ABANDONED TO BE CCTV SURVEYED TO ENSURE ANY LIVE CONNECTIONS ARE CATERED FOR

DENOTES SEWERS TO BE ABANDONED

ALL EXISTING SERVICES TO BE LOCATED AT COMMENCEMENT IN ACCORDANCE WITH UNDERTAKERS REQUIREMENTS AND PROTECTED ACCORDINGLY DURING THE WORKS.

FOR LOCATION OF ACO DRAINS TO PRIVATE & SHARED DRIVEWAYS REFER TO EXTERNAL WORKS LAYOUT. ACO DRAINS TO CONNECT TO PRIVATE SURFACE WATER SYSTEM AT MOST CONVENIENT LOCATION.

FOUNDATIONS TO BE DESIGNED / CONSTRUCTED TO TAKE INTO ACCOUNT THE PROXIMITY AND DEPTH OF ADJACENT SEWERS AND DRAINS IN ACCORDANCE WITH SFA 7TH EDITION PART B.

IF THE CLIENT OR CONTRACTOR IDENTIFIES ANY DISCREPANCIES BETWEEN THE DRAWINGS PRODUCED BY REFA FOR THIS PROJECT THEN THEY SHOULD CONTACT REFA IMMEDIATELY AND BEFORE ANY WORKS COMMENCE OR PROCEED IF IN DOUBT ASK !!!

ALL PIPES TO HAVE CLASS "S" BED AND SURROUND UNLESS SHOWN OTHERWISE ALL CONCRETE PIPES TO BE CLASS 120 ALL CLAY PIPES TO BE EXTRA STRENGTH VITRIFIED CLAY ALL UPVC PIPES TO COMPLY WITH BS 4660:2000 & BS EN 1401-1 STRUCTURED WALL UPVC PIPES TO COMPLY WITH WIS 4-35-01 MAX. PIPE LENGTH TO BE 3.0m


TO CATER FOR ANY DEVIATIONS IN THE AS CONSTRUCTED ROAD / FOOTPATH LEVELS IN RELATION TO THE DESIGN LEVELS, THE PROPOSED FLOOR LEVELS SHOWN MUST BE CHECKED ON SITE BY THE SITE AGENT OR ENGINEER IN RELATION TO AS BUILT ROAD LEVELS TO ENSURE COMPLIANCE WITH PART M OF THE BUILDING REGULATIONS

CONTRACTOR TO BE AWARE OF AND TAKE APPROPRIATE ACTION TO ENSURE THAT STABILISATION OF ANY EXISTING STRUCTURES, TREES, EMBANKMENTS OR OTHER FEATURES DOES NOT OCCUR AS A RESULT OF ANY EXCAVATIONS WORKS UNDERTAKEN IN ACCORDANCE WITH THE DESIGNS SHOWN ON THIS DRAWING IF CONTRACTOR IS UNSURE ABOUT ANY ASPECT OF THE ABOVE HE SHOULD SEEK ADVICE BEFORE COMMENCING EXCAVATION WORK.

CELLULAR STORAGE
CELLULAR STORAGE TO CATER FOR EVENTS
UP TO AND INCLUDING THE 1 IN 100 YEAR + 45% CC EVENT

PLAN AREA = 275m²
OVERALL CELL HEIGHT = 1200mm
INVERT LEVEL = 120.800m AOD
30YR TWL = 121.456m
100YR + 45% CC TWL = 121.783m
TO BE LAID AT A GRADIENT OF 1 IN 400 FALLING TOWARDS INLET/OUTLET MANHOLE
WITH REMOTE VENT FROM TOP OF STORAGE TO PREVENT AIR LOCKING

HYDROBRAKE DETAILS	
MH. No.	HB1
TYPE	CTL-SHE-0172-1500-1200-1500
DESIGN HEAD (m)	1.200
MAX. FLOW (litres/sec)	15
ORIFICE DIA. (mm)	172mm
SURCHARGED OUTFALL PIPE	N

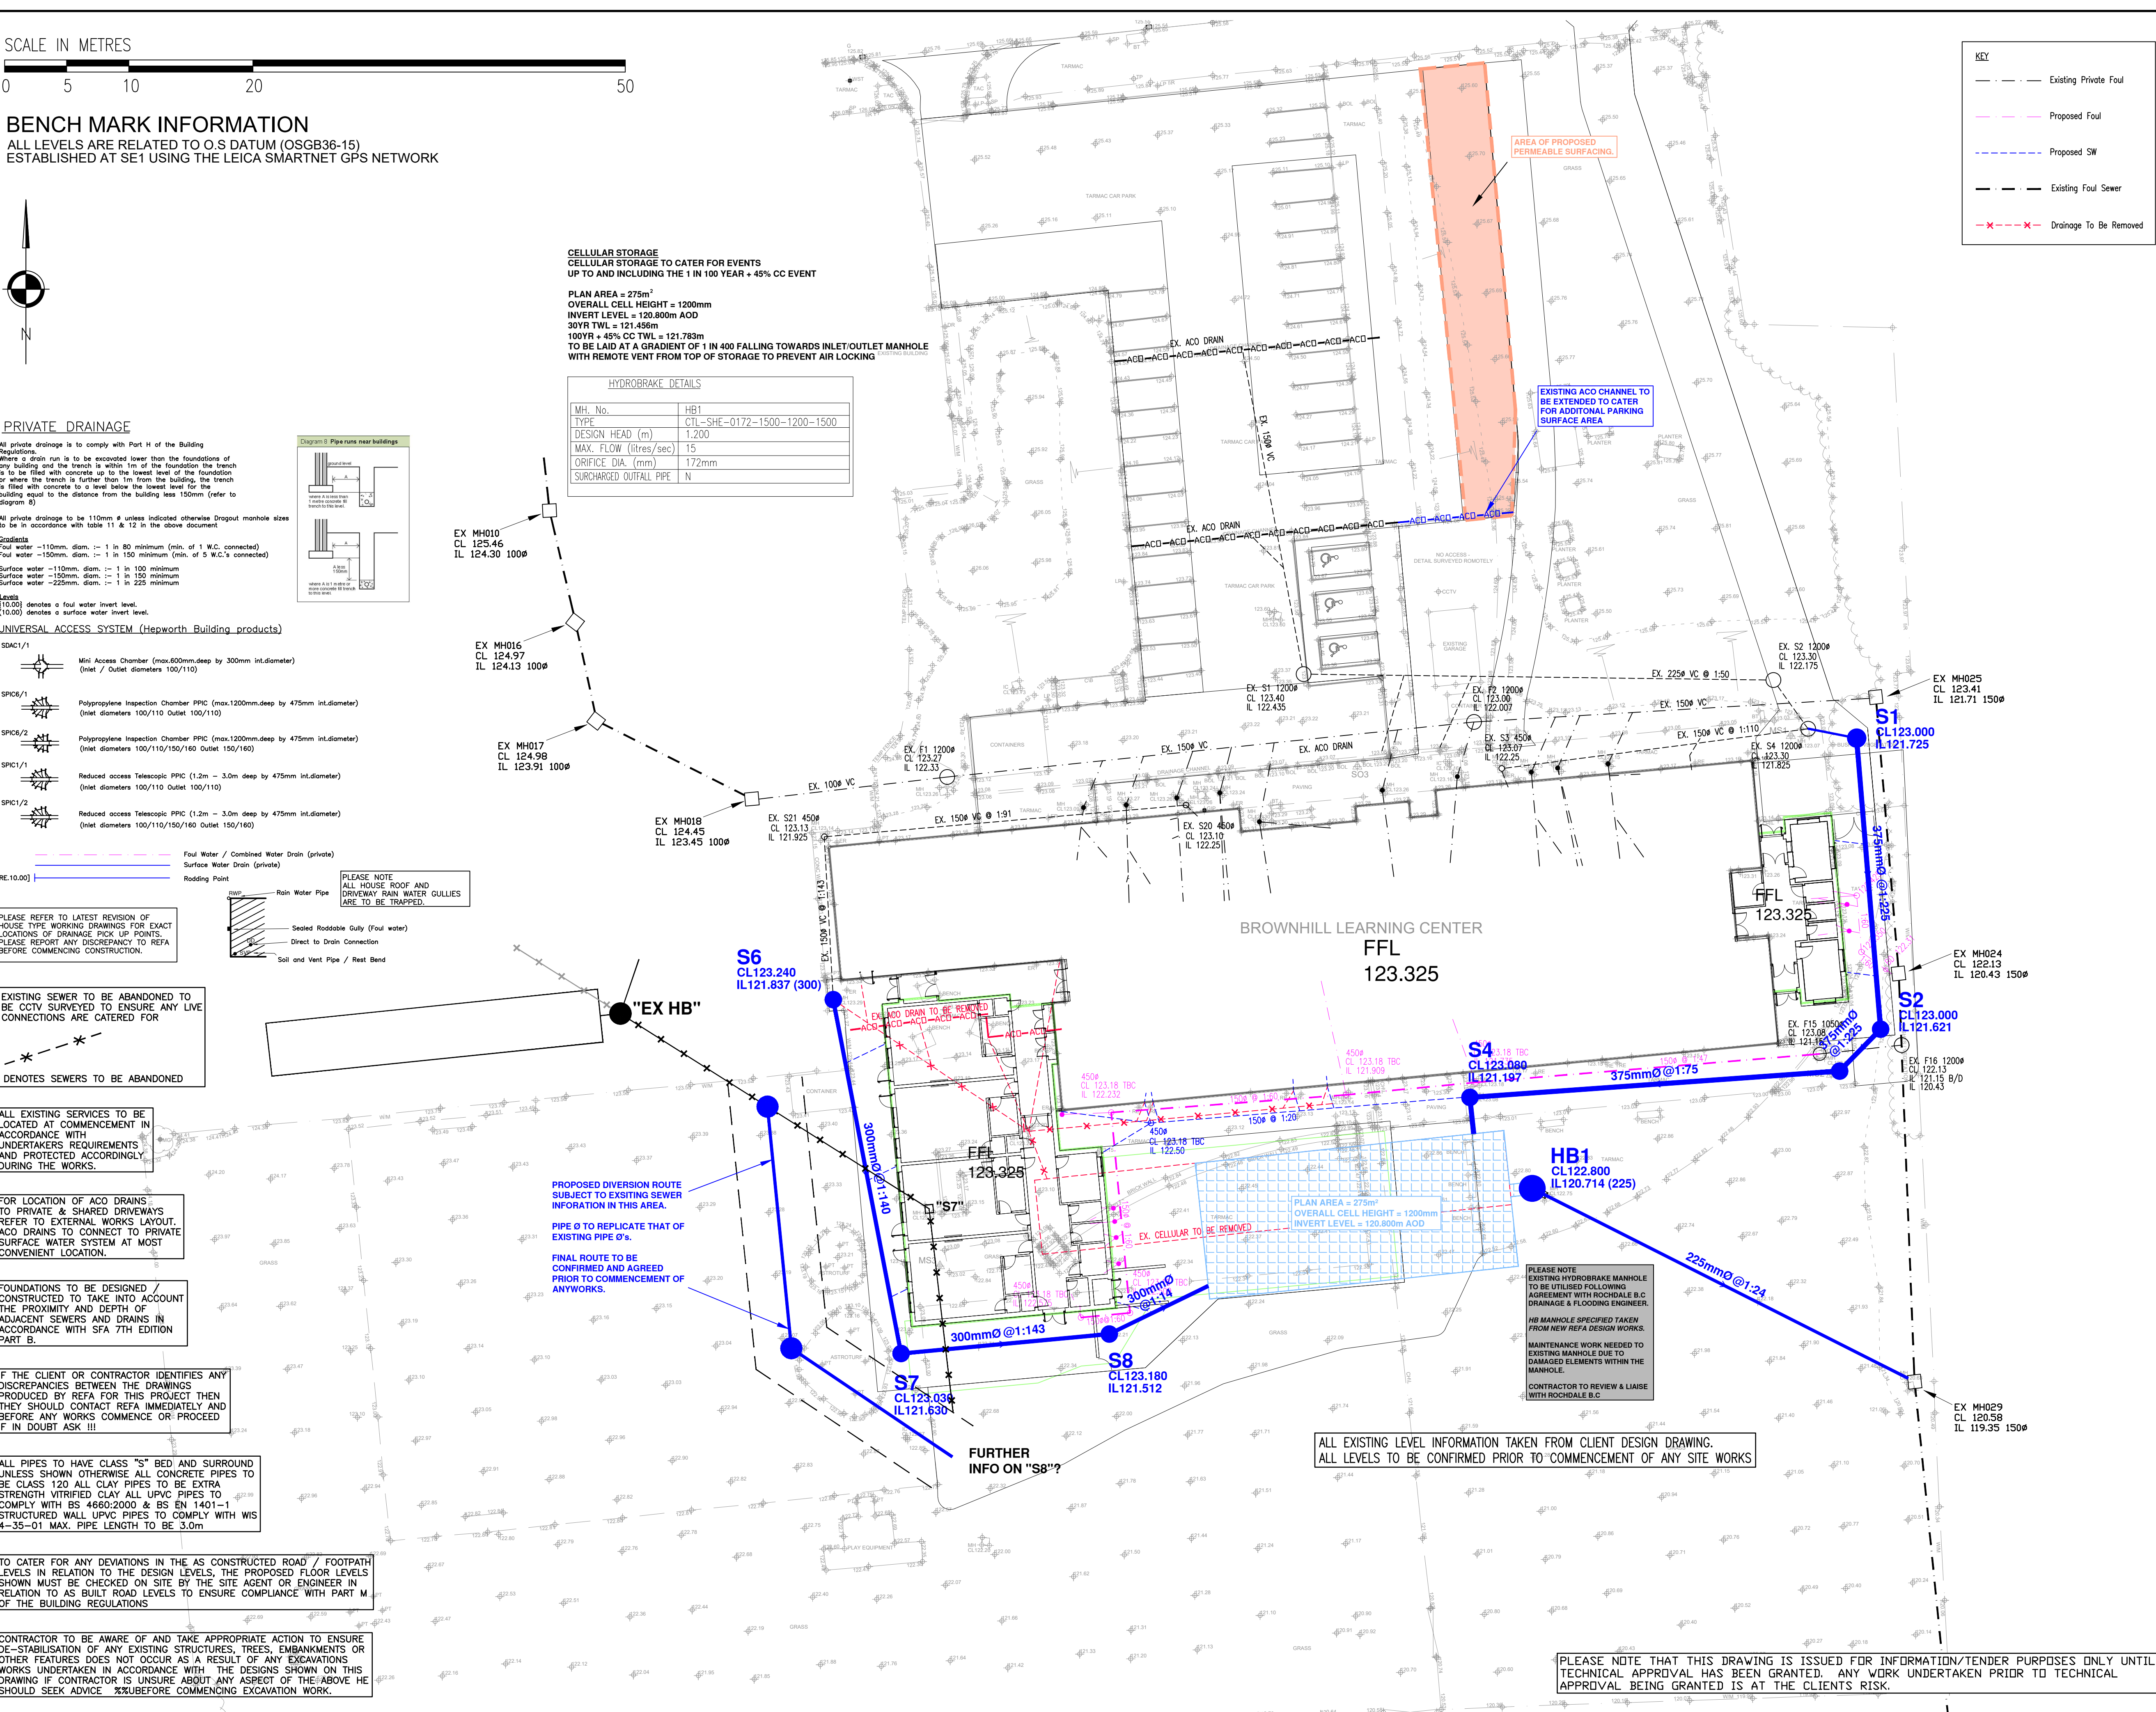

KEY	
---	Existing Private Foul
---	Proposed Foul
---	Proposed SW
---	Existing Foul Sewer
---	Drainage To Be Removed

GENERAL

- All adaptable sewers and associated works are to comply fully with "Design and Construction Guidance" & Local Practices
- All highway works to be to adaptable standards and to comply fully with the Local Authority specification.
- All private drainage works are to comply fully with part H of the Building Regulations
- All existing invert levels to be checked by the Contractor at the start of works and any discrepancies notified to REFA.
All levels are based on topographical survey information provided by others.
- All materials to bear the relevant B.S. Kitemark and comply fully with the specifications.
All concrete & concrete products must use Sulphate resistant cement (unless the site investigation report proves that sulphate attack from soils and groundwater will not occur)
- All opening notices etc. as required under highways acts etc. are to be obtained prior to commencement of works.
All works are to be inspected by LA, NHBC or Relevant Water Authority as applicable.

C.D.M. REGULATIONS 2015

In line with the above regulations we are obliged to inform the Client of their responsibilities under section CDM 15/1, and residual risks that may be encountered in the construction of these works. All design work has been carried out with Health and Safety aspects given full consideration. Wherever possible risks have been eliminated from the design, however due to the very nature of this type of work it is not possible to remove all the risks from the design.
We would also respectfully remind the Client of his obligations to take all reasonable steps in ensuring that only competent Contractors who have a valid safety policy are employed.
They should also provide satisfactory responses at tender stage as to the manner in which they will deal with the elements of risk involved in this type of work and in particular those highlighted by REFA below:-

- Support / treatment for ALL excavation work.
- Guarding to edges of excavations to prevent people, materials and vehicles falling into excavation.
- Guarding of excavations outside working hours to prevent unauthorised access.
- Undermining to adjacent roads or structures.
- Confined space operations.
- Dealing with existing services.
- Traffic management on existing highways.
- Procedure to be followed in event of accident or emergency.
- Method of working where contaminated ground is present on site.
- Confirmation will be required that all operatives are adequately trained, copies of relevant training certificates to be supplied.

The above list is by no means exhaustive but it does highlight operations that present a risk to contractors and the general public.
For clarification on any item please contact REFA.

Rev	Revision details	RevBy	Date
C	CONSTRUCTION ISSUE AS CLIENTS REQUEST	PT	27.06.24
B	PERMEABLE AREA & ACO PROPOSALS AMENDED FOLLOWING ROCHDALE B.C. COMM.	PT	05.06.24
A	REVISED TO NEW LAYOUT REVISED TO INCLUDE B.C. COMMENTS	PT	05.06.24

www.smasitd.com	
worksafe designer	SSIP
SAFETY SCHEMES IN PROCUREMENT	

Drawing Stage	Drawing Status
Draft	Comments
Issued	Information
	Approval
	Tender
	Construction
	As Built

Client

ROCHDALE

BOROUGH COUNCIL

Job title

BROWNHILL LEARNING COMMUNITY

SUTHERLAND ROAD, HEYWOOD

Drawing title

PROPOSED SURFACE WATER

DRAINAGE DESIGN

REFA
CONSULTING ENGINEERS
CIVIL • STRUCTURAL
GEOTECHNICAL • ENVIRONMENTAL

45 Bridgeman Terrace
Wigan, Lancs
WN1 1TT
Tel: (01942) 826020
Fax: (01942) 230816

Date	Scale	Drawn
29.08.23	1:250	RW / PT

DRAWING No	23062/100/1	Rev
		C

This drawing is the property of REFA and should not be copied, used or its contents divulged without prior written consent.