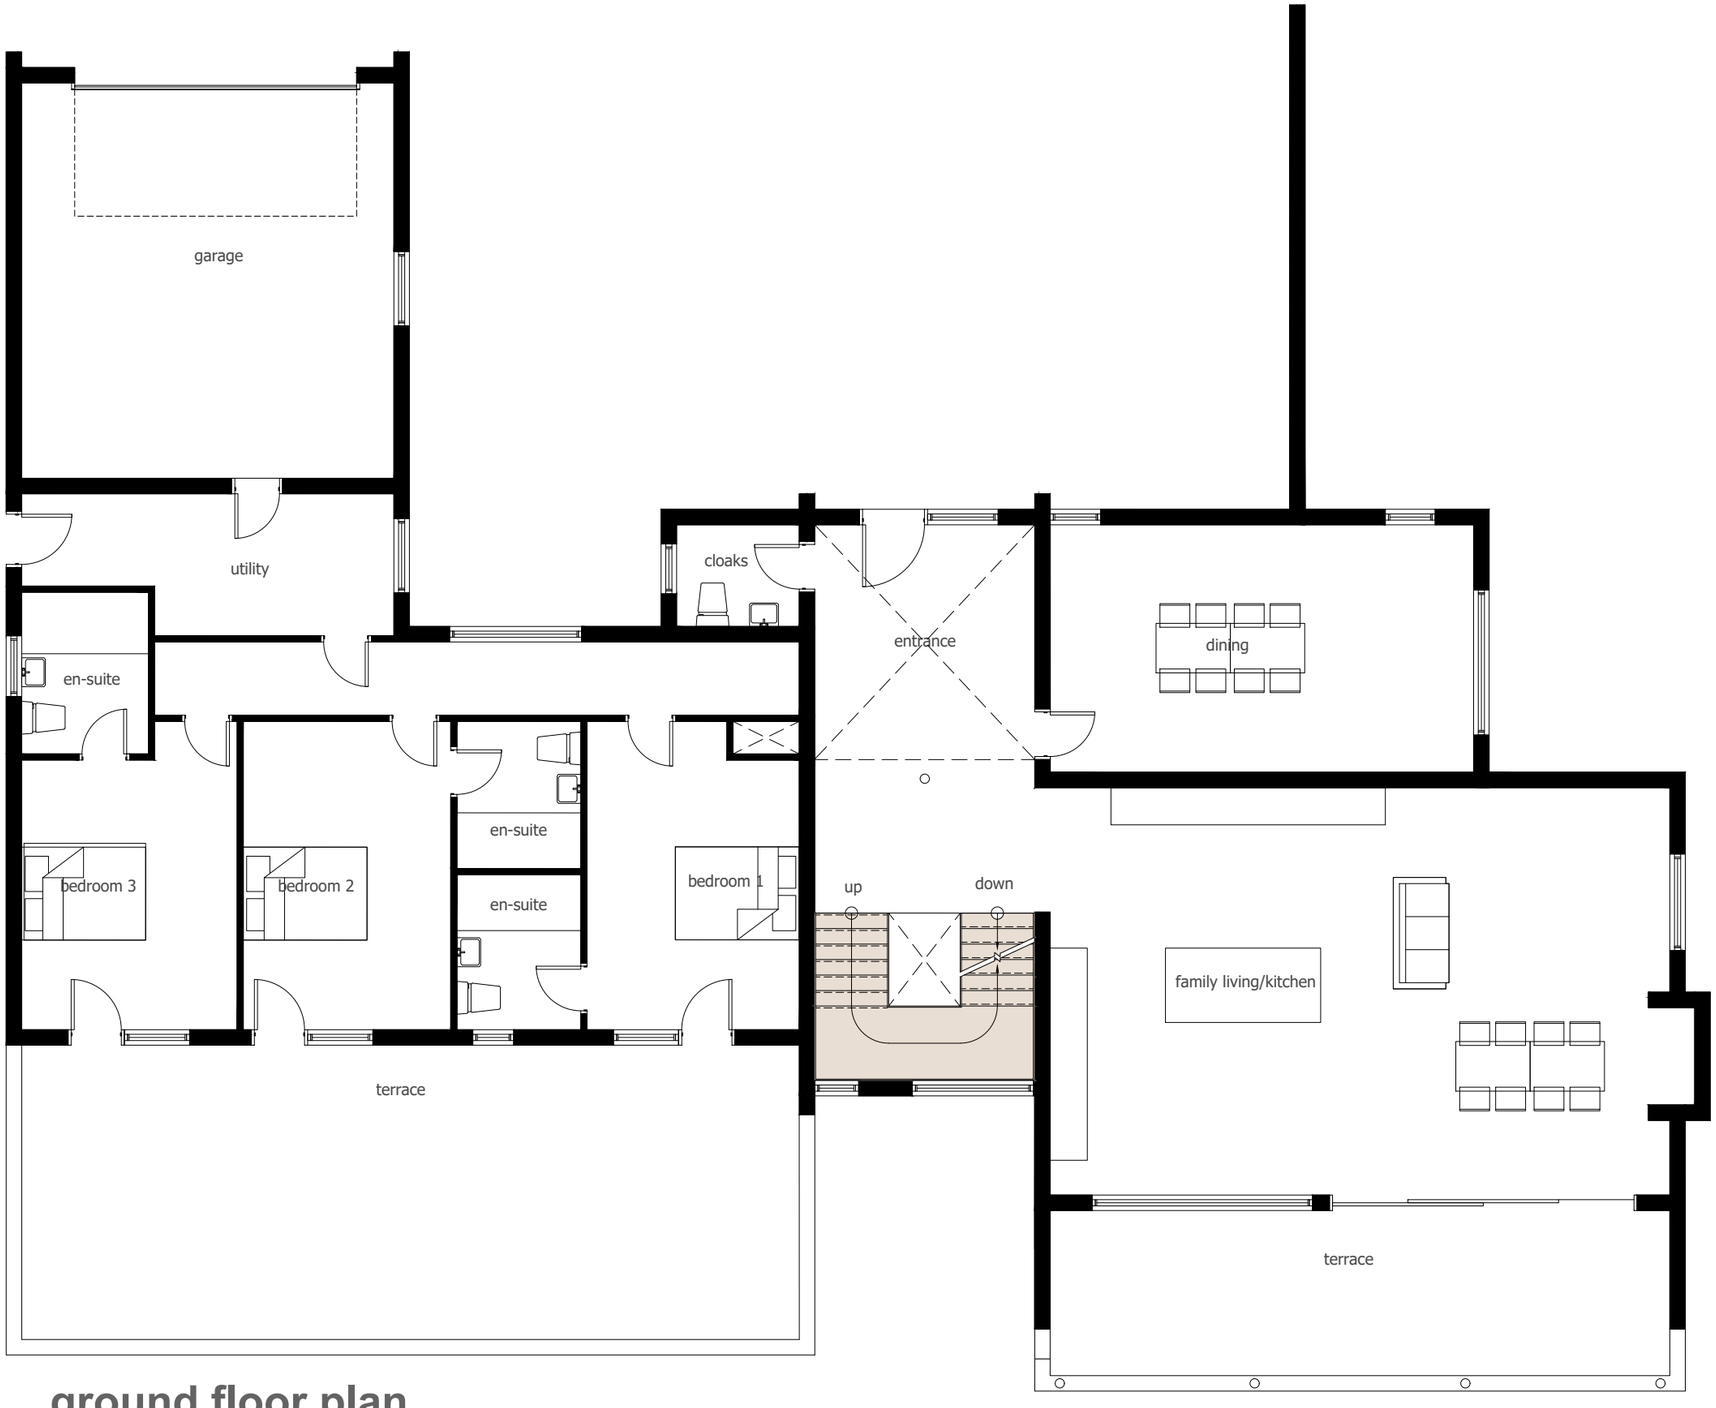


ground floor plan

Kieren and Jo McDonnell Proposed Eco Home Mill House Farm Overtown Lane Norden	Ground Floor Plan **AS BUILT** work to figured dimensions © CJ Partnership owns the copyright of this design / drawing which must not be reproduced in whole or in part without the written permission of CJ Partnership	contract no 3396 drawn by PDC	drawing no 15 date November 2015	revision A scale @ A3 1:100	Revisions: A. Cloaks room reduced in size further to re-measure.PDC.03.10.2023	Blue Pit Mill Queensway Castleton Rochdale OL11 2PG +44 (0)1706 631347 info@cjpartnership.com www.cjpartnership.com	CJ PARTNERSHIP ENVIRONMENTAL ARCHITECTS