Hatch Key:

Coloured areas of hatch on interior elevations indicate proposed fixtures, fittings or built fabric, proposed to be inserted, as below:


(Light Blue) - Proposed to be added, viewed in elevation.


(Dark Blue) - Proposed to be added cut through by plane of view.

Note:

- This proposed drawing is the consented drawing included in approved application 20/00616/LBC, with updates carried out during the on-site work identified in red bubbles. Consent is sought in this application for the updates shown in red bubbles. This drawing should be read in conjuction with the document titled 'Tracker - Updates During On-Site Works - Rochdale Town Hall', and the accompanying Schedule of Images.

First Floor Key Plan
1:500

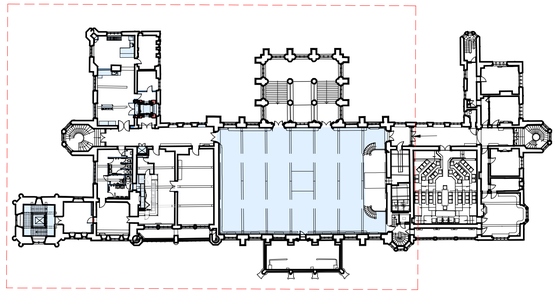

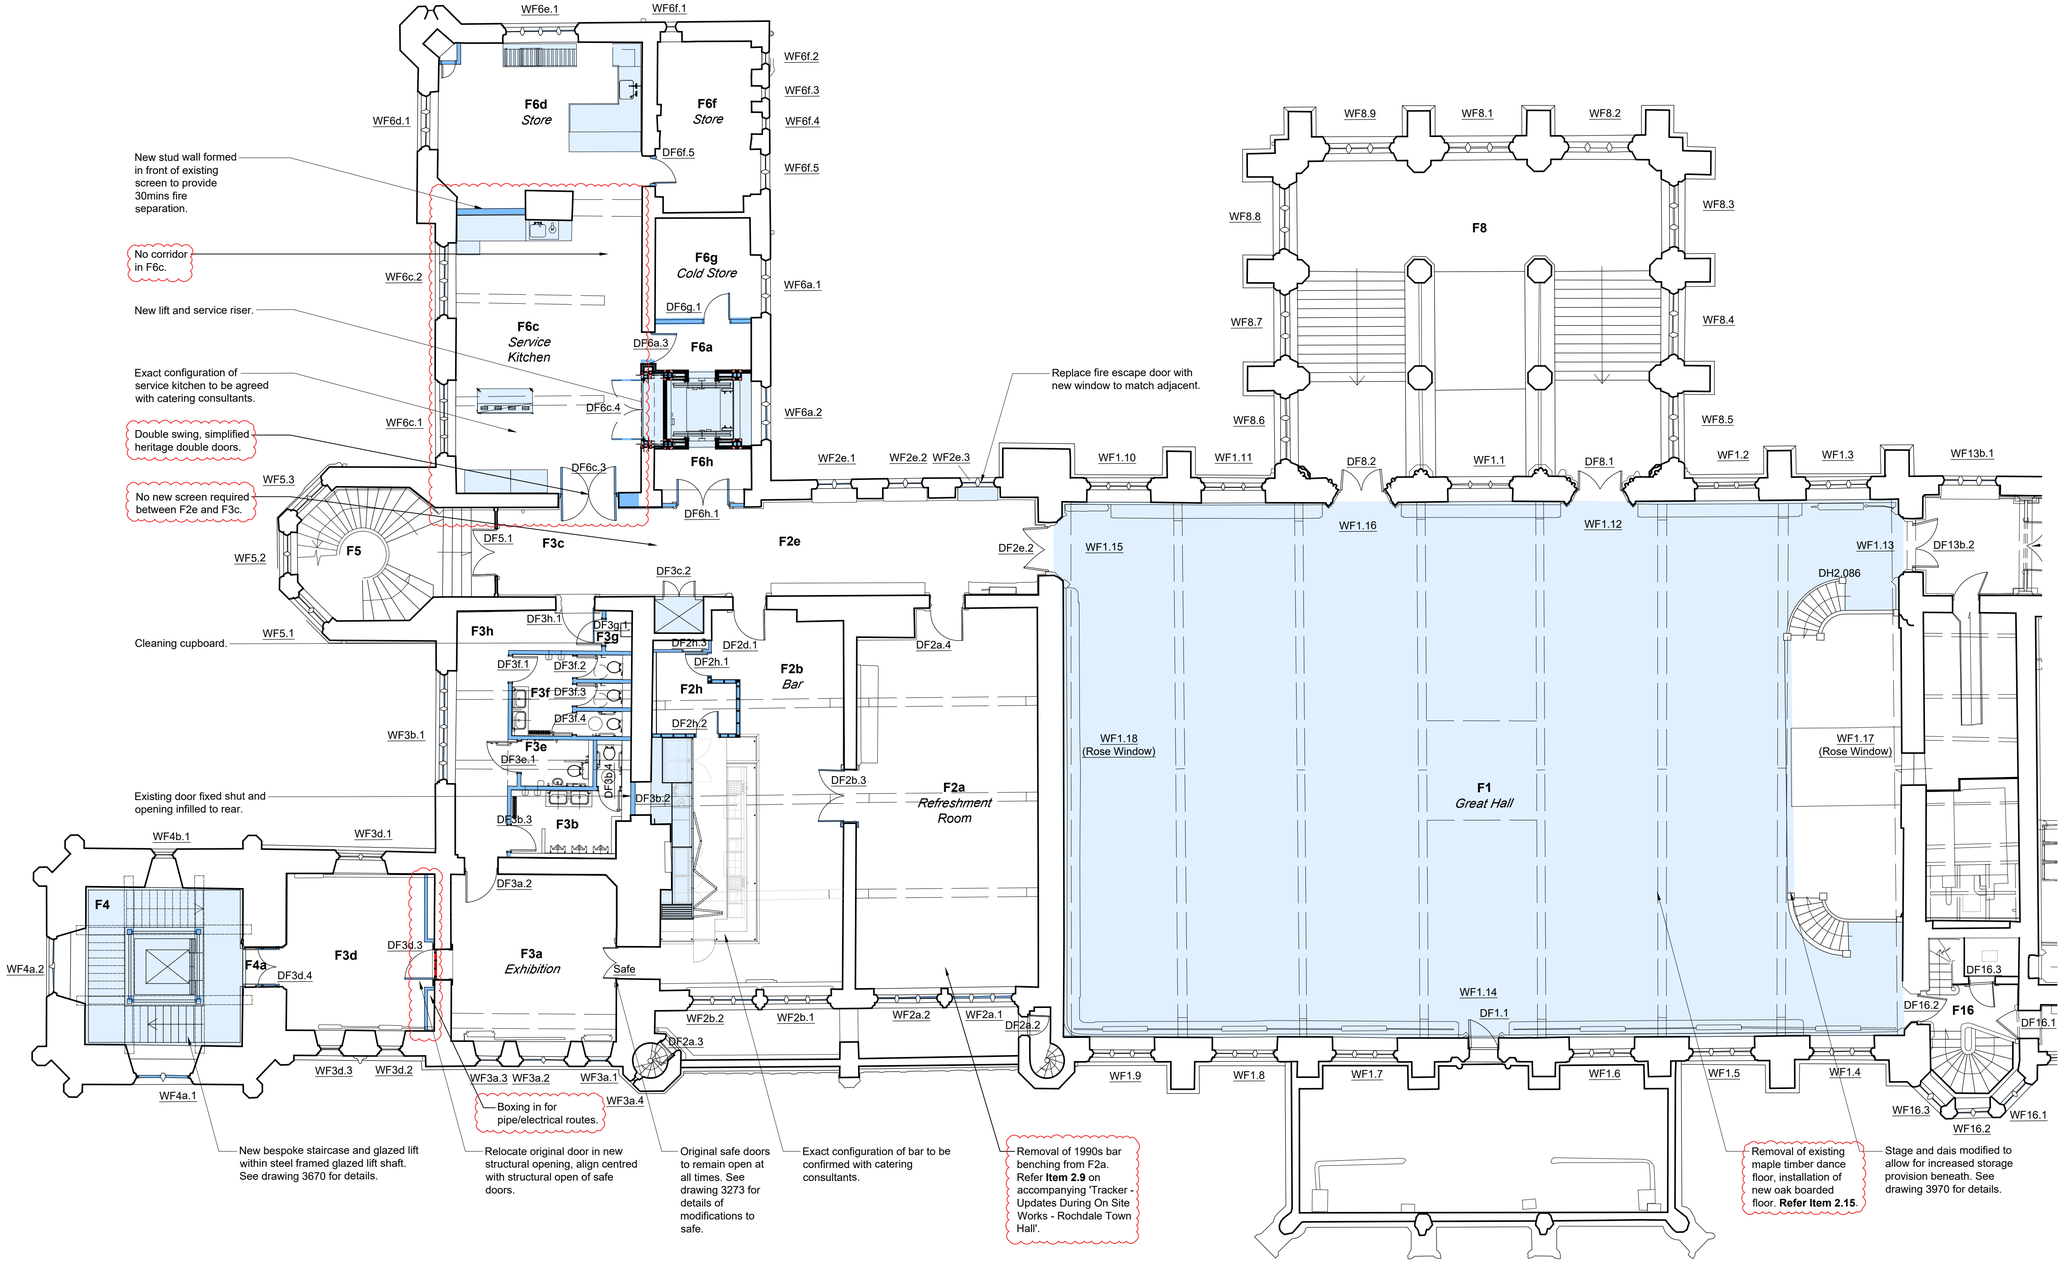

0 1 2 5
Scale 1:100 m

Notes

1. Any dwg format drawing is to be read in conjunction with and at the scale of the accompanying pdf.
2. Where colours other than black or grey are used, the drawing must be plotted in colour.
3. For status 'C' (Construction) drawings all dimensions are to be checked on site by the contractor, scaling is for Local Authority purposes only.
4. Unless otherwise indicated, all dimensions are in millimeters.
5. All information on this drawing is to be read in conjunction with the relevant Donald Insall Associates specification and trade contractors' drawings and information by specialists.
6. In the event of any discrepancy, please contact us immediately.
7. This drawing may contain survey information by others and is to be used solely for the purposes for which it was issued.
8. These are uncontrolled documents issued for information purposes only. If you have any queries regarding the drawings, please contact DIA immediately.
9. Please note DIA cannot be held responsible for any errors arising from changes made to an uncontrolled dwg file.

© 2019 DONALD INSALL ASSOCIATES LTD

Status codes

S0	Work in Progress	**D1**	Suitable for Costing
S1	Suitable for Co-ordination	**D2**	Suitable for Tender
S2	Suitable for Information	**D3**	Suitable for Contractor Design
S3	Suitable for Review & Comment	**D4**	Suitable for Manufacture/Procurement
S4	Suitable for Stage Approval		

A1,A2,A3, An etc. Approved and accepted as stage complete
B1,B2,B3, Bn etc. Partially signed off: with minor comments from the Client
CR Construction Record

Rev	Date	Dwn	Auth	Revision
P05	18-01-24	SZG	CXD	Updates to reflect agreed on site changes.
P04	22-05-20	EXW	RZM	Updated following client amendments, RIBA 3 & consents
P04	30-04-20	SZG	RZM	Plans updated following access consultant comments.
P03	02-04-20	SZG	RZM	Plans updated to reflect Phase 1/Phase 2 works division.
P02	27-03-20	SZG	RZM	Updated to co-ordinate with sub-consultant information.
P01	17-03-20	SZG	RZM	Initial Issue

Scale A1@	Status	Purpose of issue
100	S4	For Consents

File Name

Project	Originator	Volume	Level	Type	Role	Number	Revision
RTH	DIA	XX	20	DR	A	2083	P05

Rochdale Town Hall
for Rochdale Development Agency

Phase 2 - First Floor Plan
As Proposed

Donald Insall Associates
Chartered Architects and Historic Building Consultants

Bridgegate House, 5 Bridge Place, Chester CH1 1SA
(+44) 01244 350 063
chester@insall-architects.co.uk