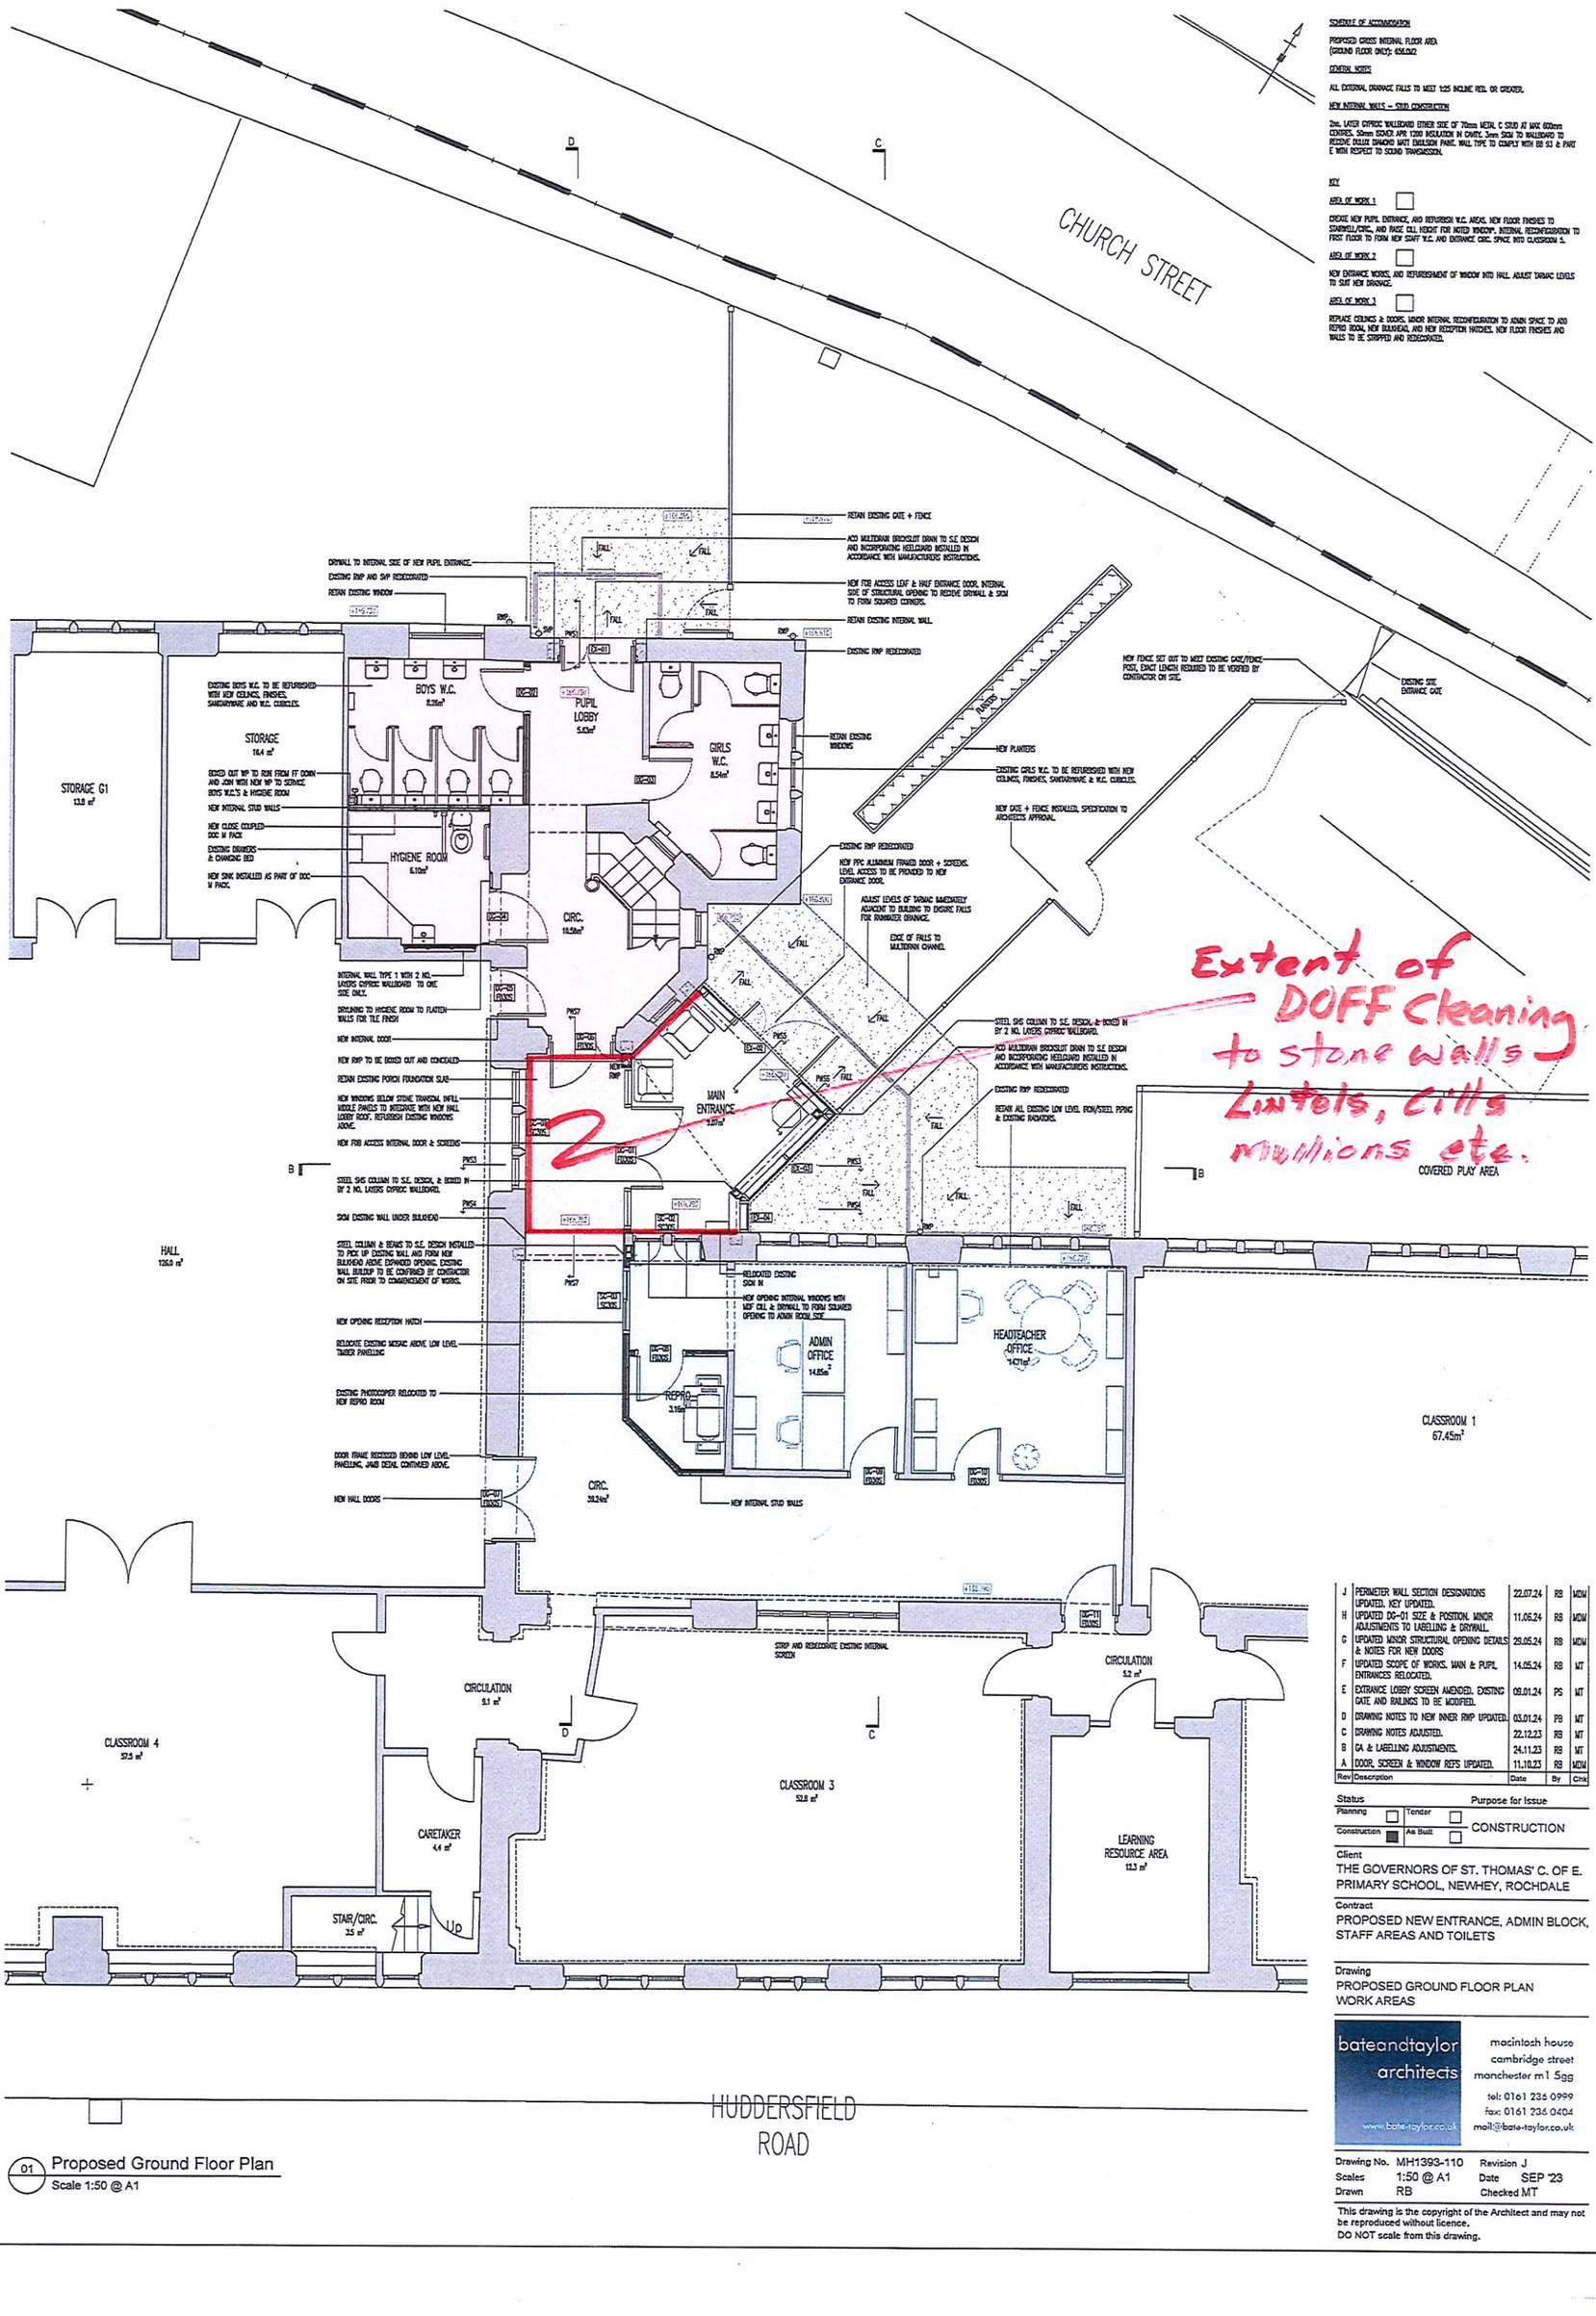


01 Proposed Ground Floor Plan
Scale 1:50 @ A1

Rev	Description	Date	By	Chk
J	PERIMETER WALL SECTION DESIGNATIONS UPDATED. KEY UPDATED.	22.07.24	RB	MDM
H	UPDATED DG-01 SIZE & POSITION. MINOR ADJUSTMENTS TO LABELLING & DRYWALL.	11.06.24	RB	MDM
G	UPDATED MINOR STRUCTURAL OPENING DETAILS & NOTES FOR NEW DOORS	29.05.24	RB	MDM
F	UPDATED SCOPE OF WORKS. MAIN & PUPIL ENTRANCES RELOCATED.	14.05.24	RB	MT
E	ENTRANCE LOBBY SCREEN AMENDED. EXISTING GATE AND RAILINGS TO BE MODIFIED.	09.01.24	PS	MT
D	DRAWING NOTES TO NEW INNER RWP UPDATED.	03.01.24	PB	MT
C	DRAWING NOTES ADJUSTED.	22.12.23	RB	MT
B	GA & LABELLING ADJUSTMENTS.	24.11.23	RB	MT
A	DOOR, SCREEN & WINDOW REFS UPDATED.	11.10.23	RB	MDM

Status: Planning ☐ Tender ☐ Construction ■ As Built ☐ — Purpose for Issue: CONSTRUCTION

Client
THE GOVERNORS OF ST. THOMAS' C. OF E. PRIMARY SCHOOL, NEWHEY, ROCHDALE


Contract
PROPOSED NEW ENTRANCE, ADMIN BLOCK, STAFF AREAS AND TOILETS

Drawing
PROPOSED GROUND FLOOR PLAN WORK AREAS

bateandtaylor architects
www.bate-taylor.co.uk
macintosh house
cambridge street
manchester m1 5gg
tel: 0161 236 0999
fax: 0161 236 0404
mail@bate-taylor.co.uk

Drawing No. MH1393-110 Revision J
Scales 1:50 @ A1 Date SEP '23
Drawn RB Checked MT


This drawing is the copyright of the Architect and may not be reproduced without licence.
DO NOT scale from this drawing.

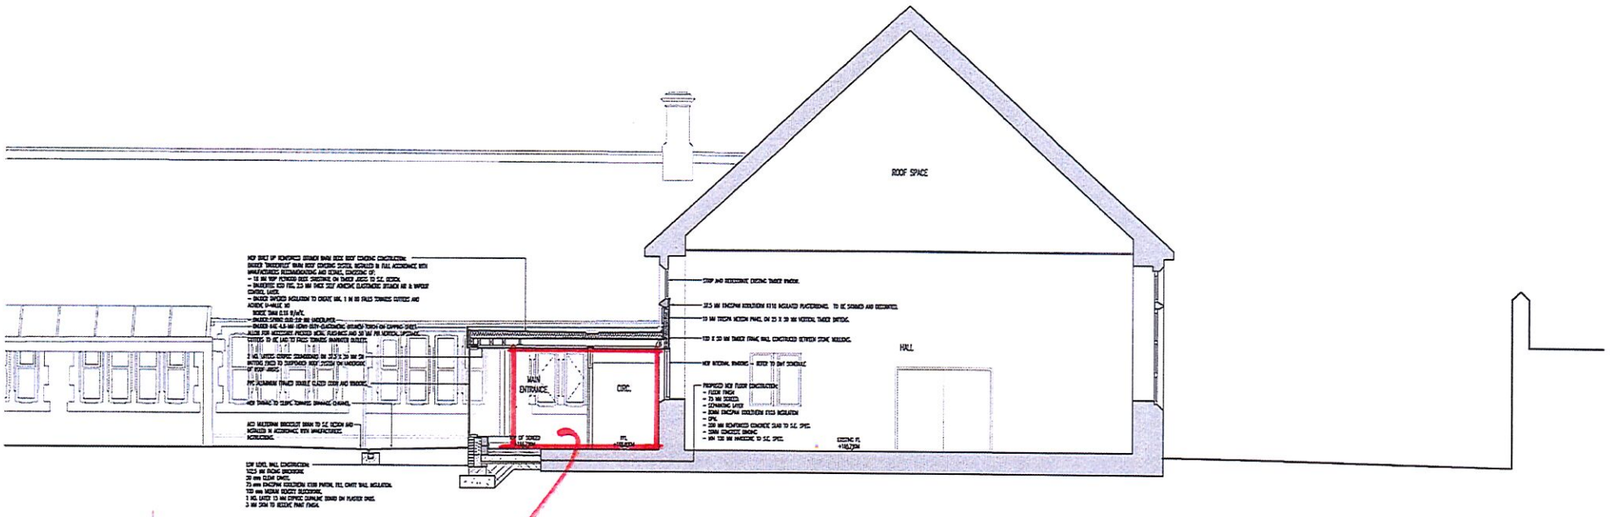

02 Proposed Section B:B
Scale 1:50 @ A0



03 Proposed Section C:C
Scale 1:50 @ A0

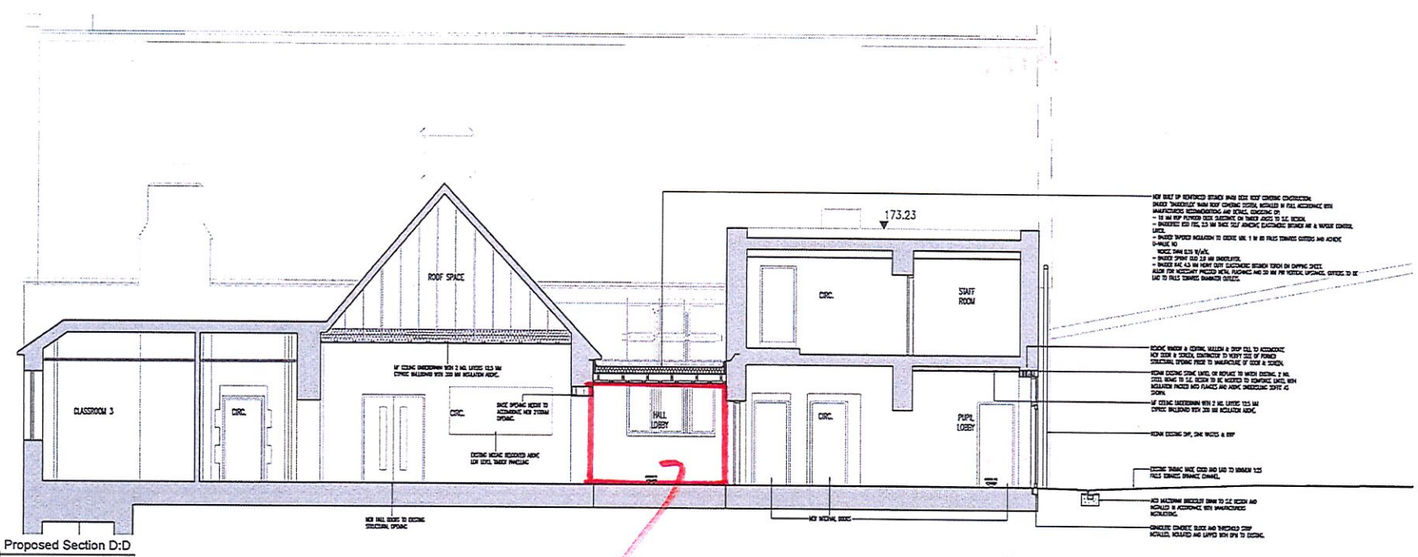

04 Proposed Section D:D
Scale 1:50 @ A0

Rev	Description	Date	By	Chk
E	ADJUSTED TO REFLECT OPTION 2.	22.07.24	RB	MCM
D	ADJUSTED TO MATCH EDGE STRUCTURAL INFORMATION.	11.06.24	RB	MCM
C	UPDATED SCOPE OF WORKS. SECTION A-A REMOVED.	14.05.24	RB	MT
B	DETAILS & NOTES UPDATED FOR NEW LINTELS.	22.12.23	RB	MT
A	CL ADJUSTMENTS. SOME CEILINGS LOWERED. UPDATED SYSTEMONE.	24.11.23	RB	MT

Status: Purpose for Issue
Planning ☐ Tender ☐
Construction ☒ As Built ☐
CONSTRUCTION

Client
THE GOVERNORS OF ST. THOMAS' C. OF E. PRIMARY SCHOOL, NEWHEY, ROCHDALE

Contract
PROPOSED NEW ENTRANCE, STAFF AREAS, ADMIN BLOCK & TOILETS

Drawing
PROPOSED SECTIONS

bateandtaylor architects
www.bateandtaylor.co.uk
macintosh house
cambridge street
manchester m1 5gq
tel: 0161 236 0999
fax: 0161 236 0404
mail@bateandtaylor.co.uk

Drawing No. MH1393-117 Revision E
Scales 1:50 @ A0 Date SEP '23
Drawn RB Checked MT

This drawing is the copyright of the Architect and may not be reproduced without licence.
DO NOT scale from this drawing.