
NOTES:
1. DO NOT SCALE FROM THIS DRAWING. USE FIGURED DIMENSIONS ONLY, AND CHECK ALL DIMENSIONS ON SITE.

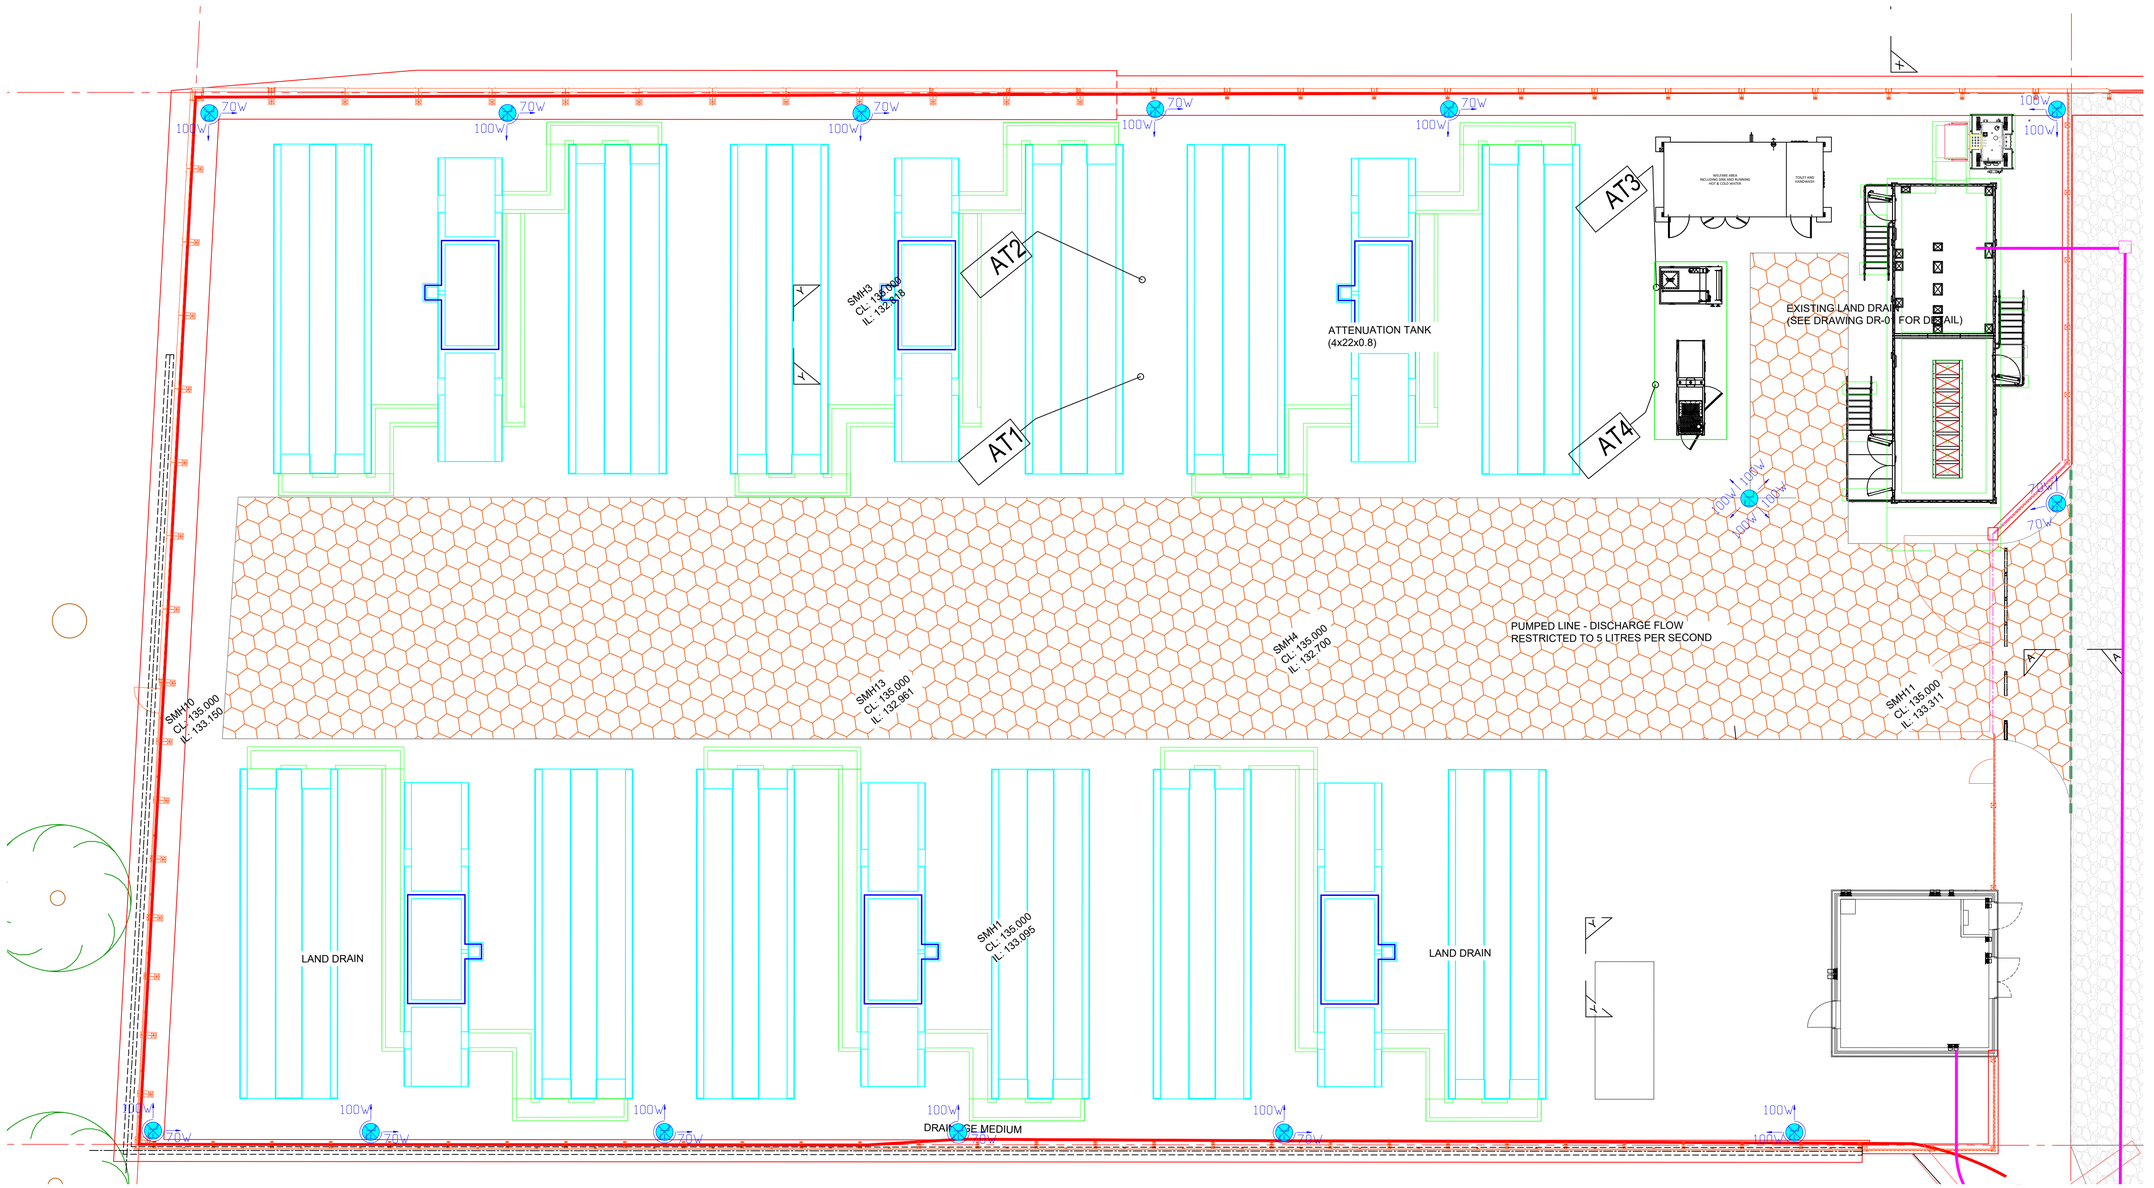


NOTES:

ALL FLOODLIGHTS TO BE:
100w BELL SKYLINE SLIM+ LED FLOODLIGHT
70w JCC TOUGHFLOOD

| Iss. | Date | Change | By |
|---|---|---|---|
| AB1 | 27-02-26 | AS BUILT – FIXTURE TYPE | L.S. |
| AB | 24-01-26 | AS BUILT | L.S. |
| P09 | 17-12-25 | NAMING UPDATED AS PER AVK REQUEST | L.S. |
| P08 | 20-10-25 | UPDATED AS PER MASDAR REQUEST | L.S. |
| P07 | 20-10-25 | AMENDMENT TO DWG NO | L.S. |
| P06 | 15-07-25 | AS PER NEW SITE LAYOUT | L.S. |
| P05 | 02-07-25 | AS PER NEW SITE LAYOUT | L.S. |
| P04 | 13-03-25 | REDUCE LIGHTING COLLUMNS | C.M. |
| P03 | 21-01-25 | REQUEST TO ILLUMINATE BANKS | C.M. |
| P02 | 01-10-24 | SWITCHROOM STAIRCASE ADJUSTED | L.S. |
| P01 | 17-09-24 | FIRST ISSUE | L.S. |

3rd Angle Projection — Do Not Scale. All Dimensions in MM Unless Otherwise Stated.

Status: S3 - REVIEW COMMENT

AVK THE POWER PEOPLE


Power Systems House
1-3 Malvern Road,
Maidenhead, Berkshire,
SL6 7RE.

Tel:01628 503900
www.avk-seg.co.uk
sales@avk-seg.co.uk


Customer: MASDAR

Site: ROYLE BARN ROAD

Title: EXTERNAL LIGHTING

| Drawn: | Date: | Scale: |
|---|---|---|
| L.S. | 27-02-26 | 1:150 |
| Checked: | Date: | Sheet Size: |
| C.M. | 27-02-26 | A1 |

Drawing No.: RBR-AVK-ADV003-XX-DR-E-30002 — Rev: AB1