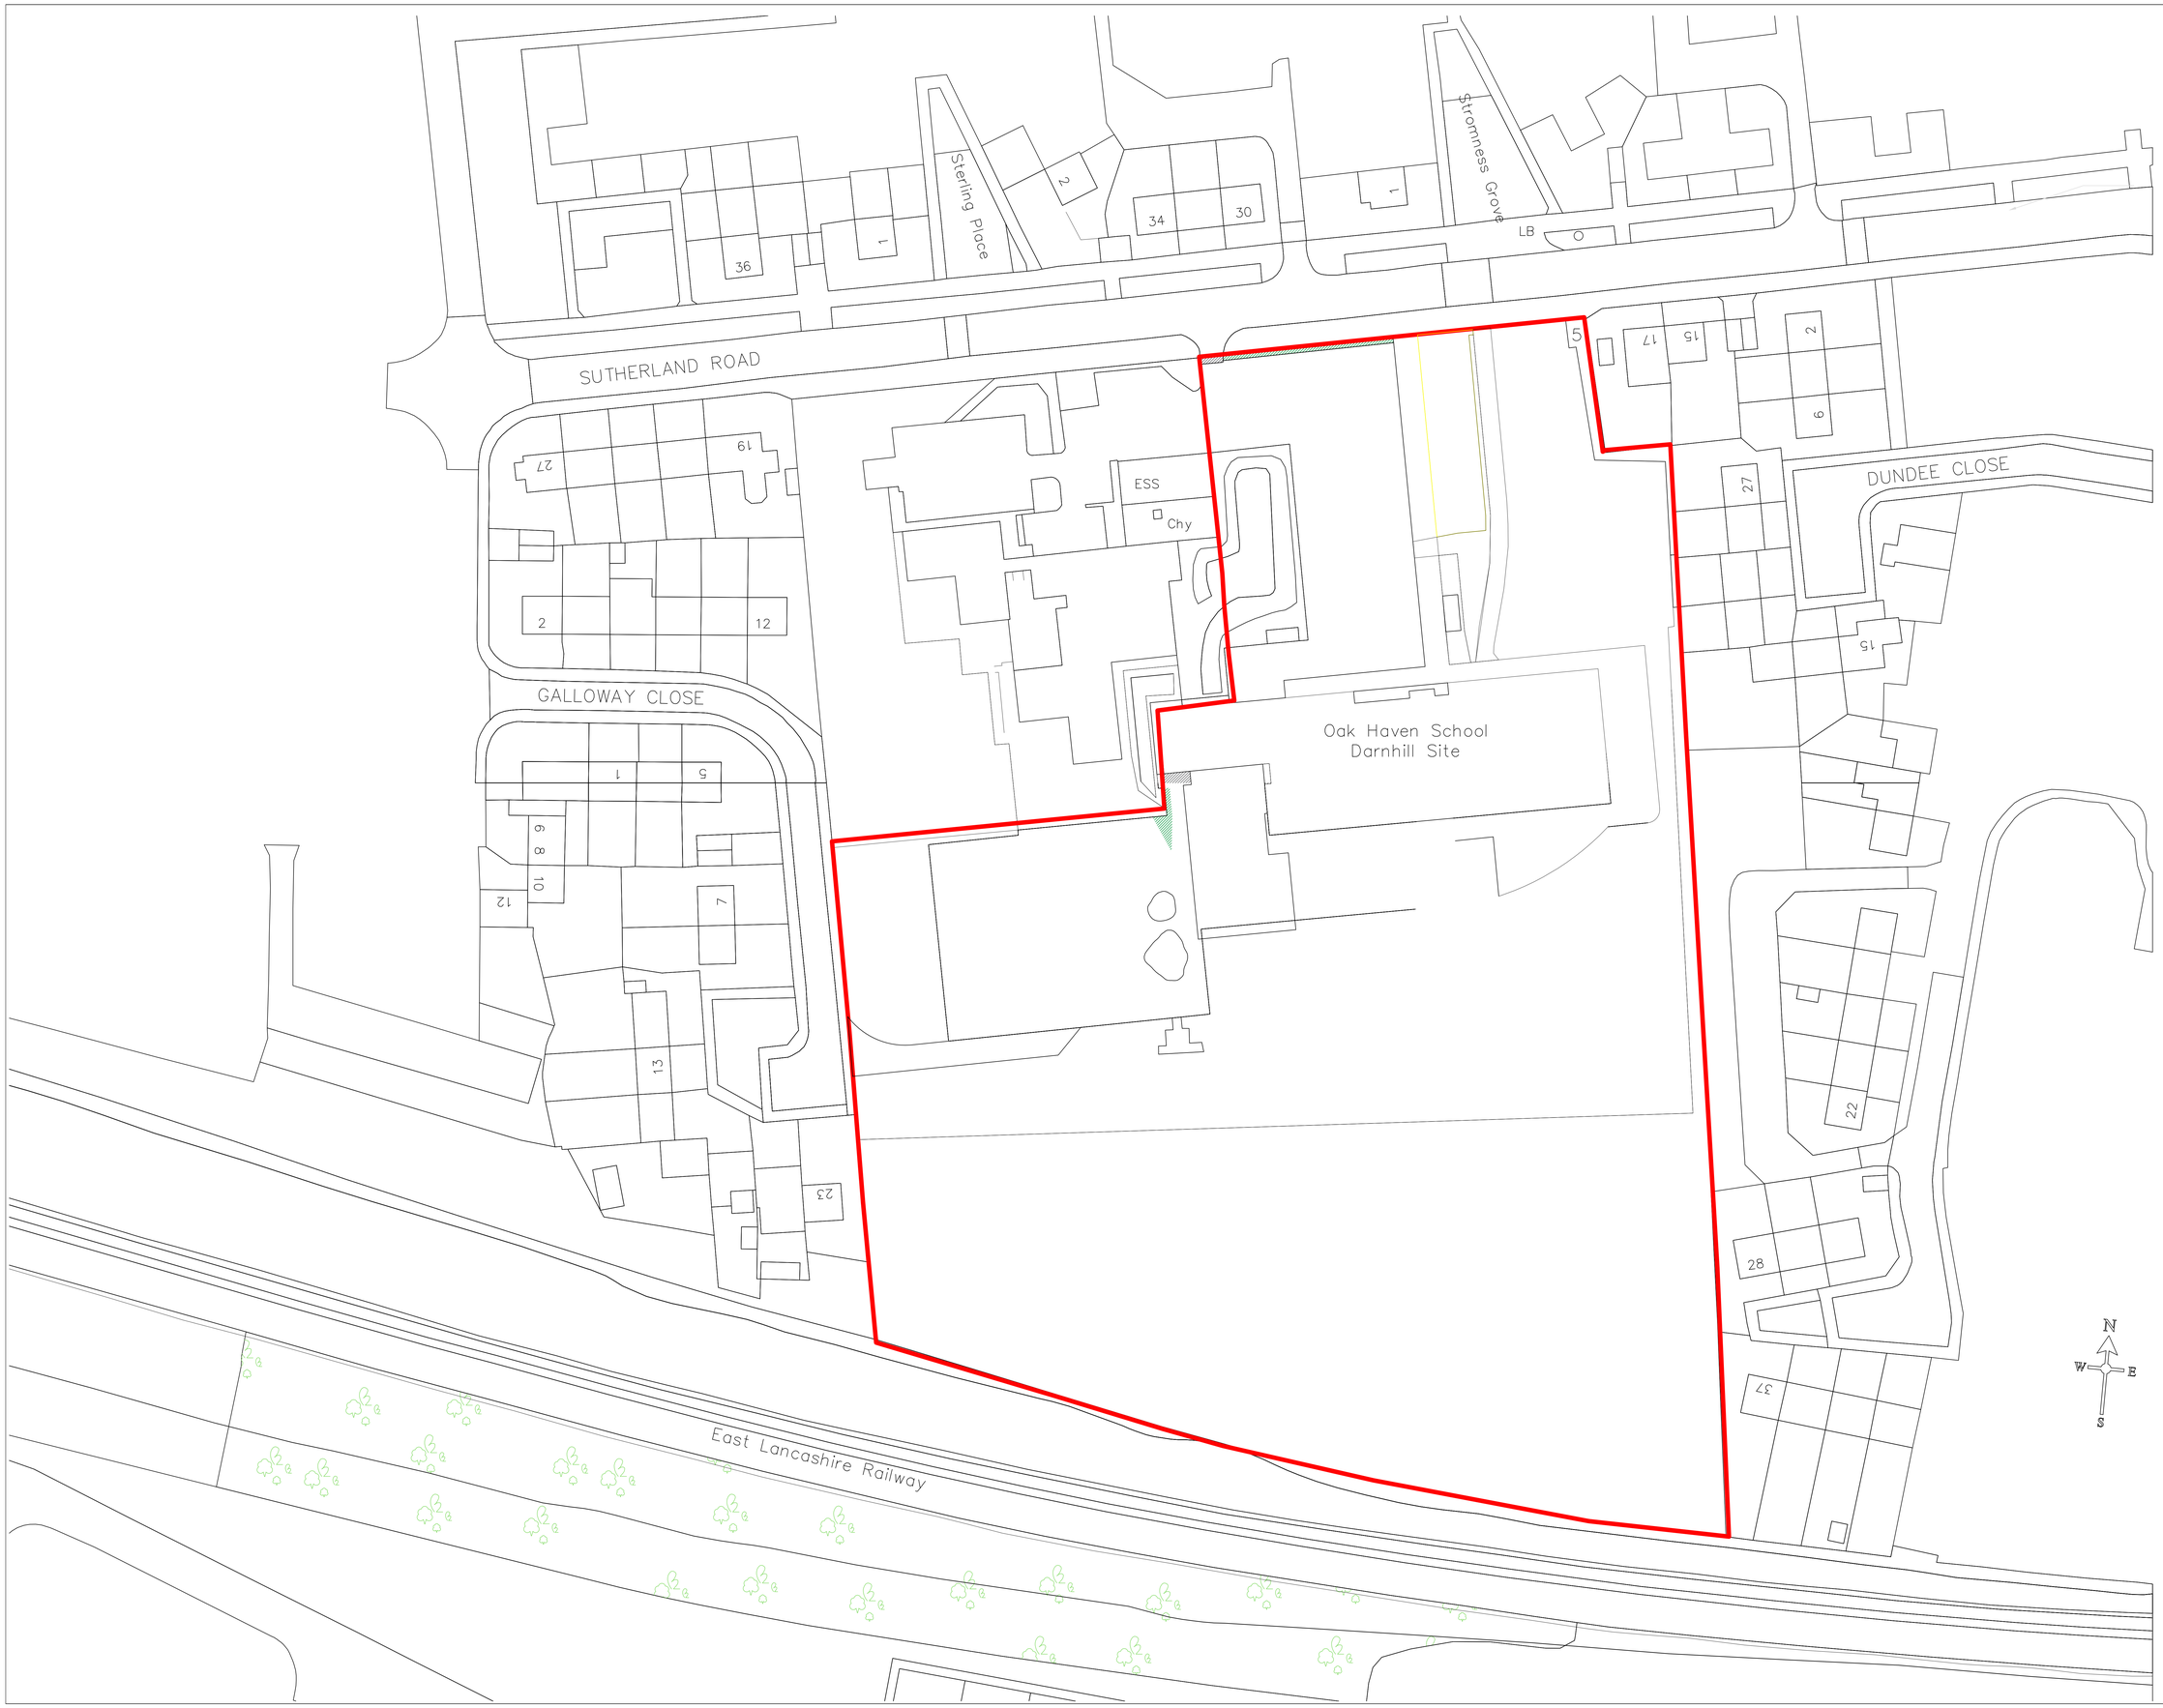


Figured dimensions to be used. Do not scale from drawing

Rev.	Revision detail	By	Chk.	Date

ROCHDALE BOROUGH COUNCIL

HIGHWAYS, PROPERTY & STRATEGIC HOUSING

www.rochdale.gov.uk
(01706) 647474

Number One Riverside
Smith Street
Rochdale OL16 1XU

Client

SCHOOLS SERVICES

Project

RAISE
OAK HAVEN SCHHOL
DARNHILL

Title

LOCATION PLAN

Drawn by	Date	Purpose of issue	Scale
AS	June 26	As-Built	1:500 @ A0
Checked by	Date	Project No.	
Approved by	Date	Drawing No.	Rev.