




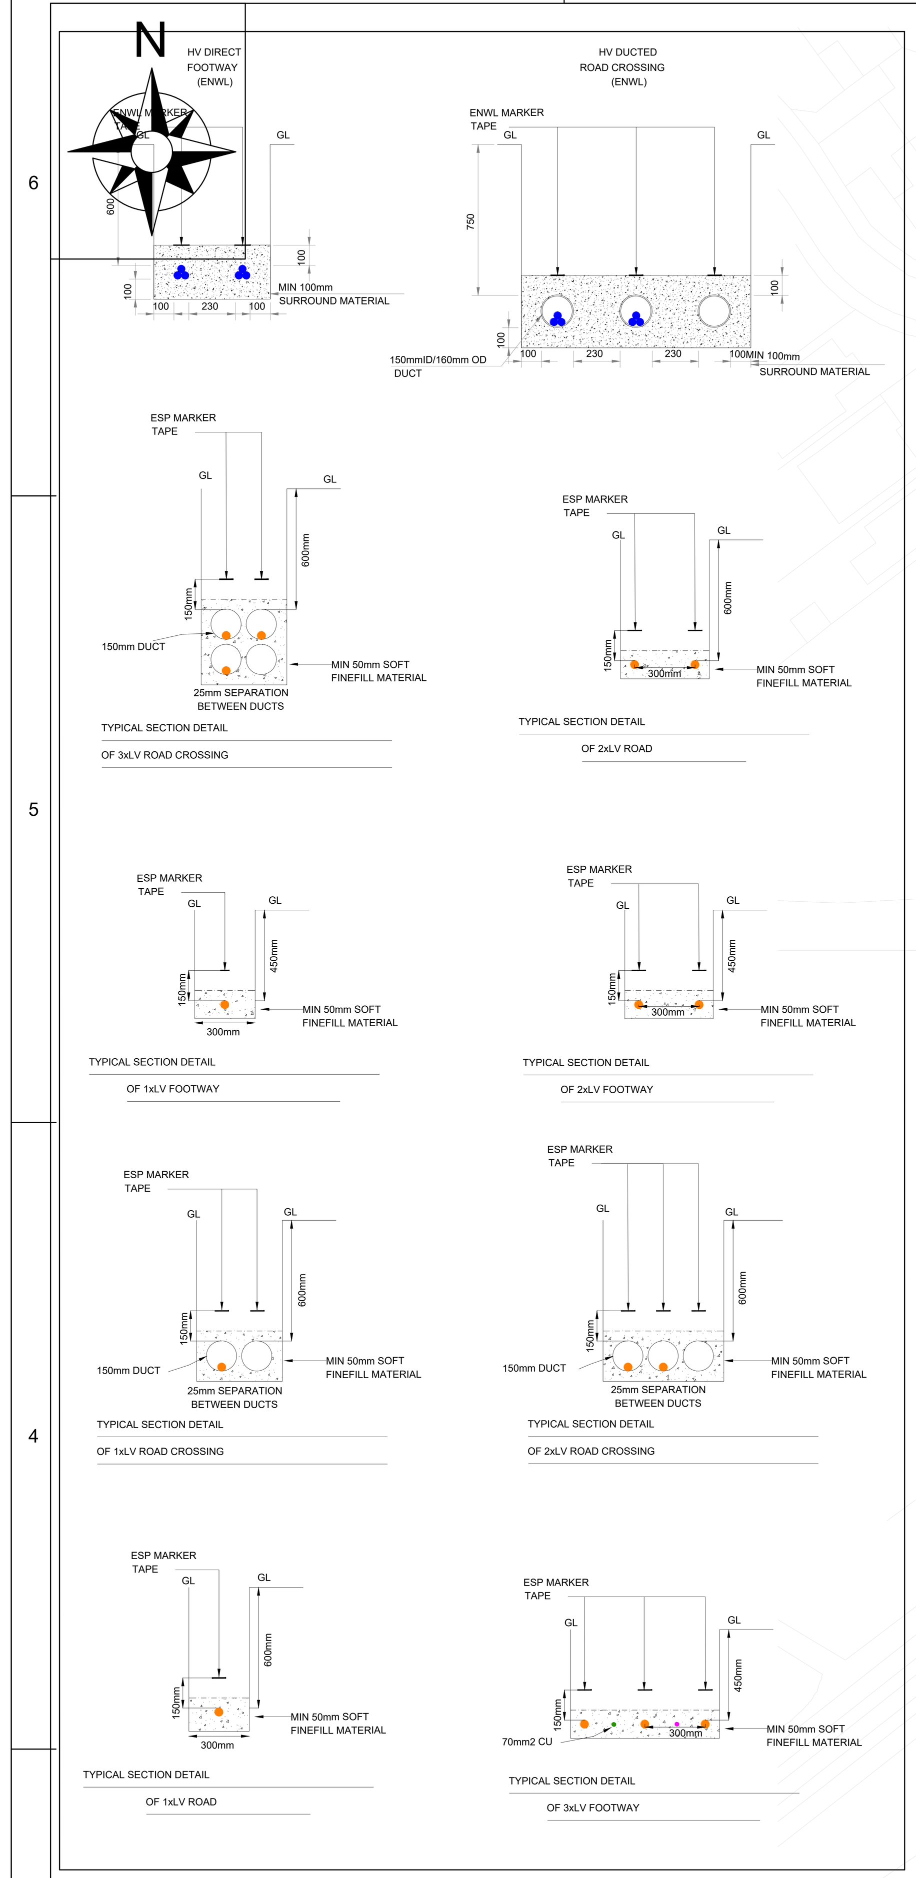


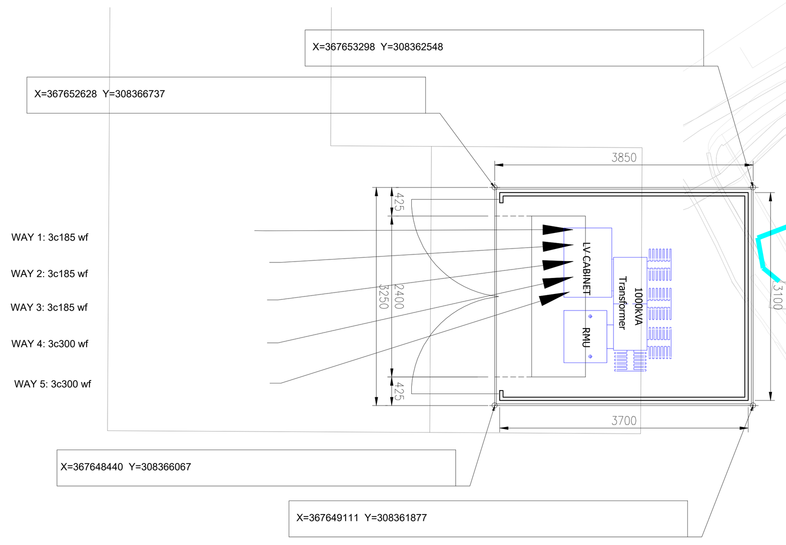

SCHEDULE				
DIAMETER OF CABLE	VOLTAGE	LENGTH (m)	NUMBER OF FITTINGS	
			JOINT's	BOTTLE END's
3c95 wf	LV	436	-	8
3c185 wf	LV	320	4	3
3c300 wf	LV	1003	10	4
-	-	-	-	-
3c300 wf	HV	100	-	-
	TOTAL	1859	14	15

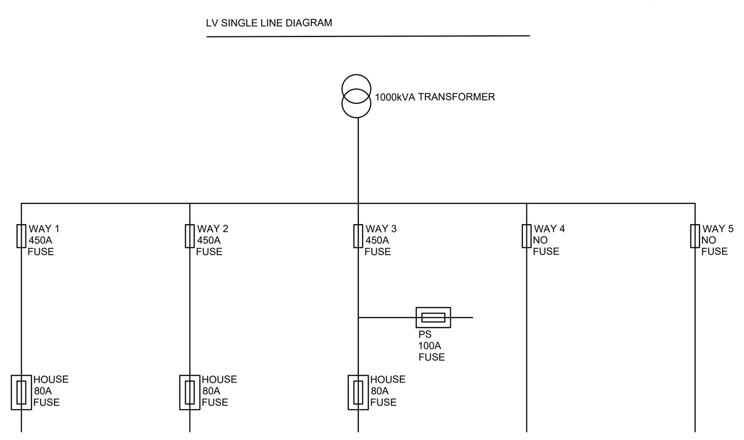

ASLAID

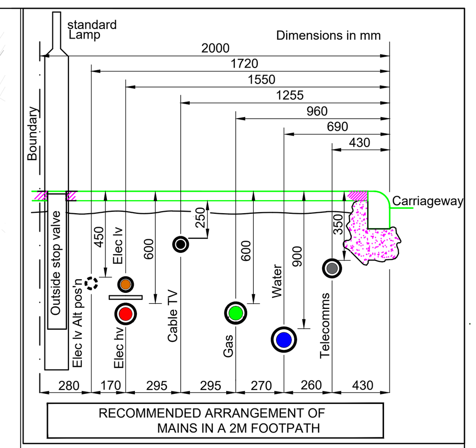

ELECTRIC KEY:

SERVICE PROPOSED	
SERVICE AS LAID	
LV MAINS PROPOSED	
LV MAINS AS LAID	
EXISTING 6.6kV	
EXISTING 11kV	
DISCONNECTED	
DIMENSION	
MBJ	MBJ
SERVICE JOINT AS LAID	
SERVICE JOINT PROPOSED	
POT END	PE
11kV JOINTS	
6.6kV JOINTS	
STREET LIGHTING	L
MINI PILLAR	
LINK BOX	
EARTH	
ROAD CROSSING DUCT	
3PH ELECTRIC METER	EM
1PG ELECTRIC METER-1ST PHASE	BR
1PH ELECTRICA METER-2ND PHASE	BL
1PH ELECTRICA METER-3RD PHASE	GY

Rev	Revision Details	Drawn By	Date
AB25	Plot 46,47 & 50 added	WM	18/05/26
AB24	Plot 44,45,48,49 & 3 xSL added	EL	23/04/26
AB23	Plot 51,2xSL added	VK	03/03/26
AB22	Plot 6-9,43,Mains added	VK	09/02/26
AB21	6xSL added	VK	18/12/25
AB20	Plot 1-5,10-11 added	VK	20/11/25
AB19	Mains added	VK	17/11/25
AB18	Plot 6-61, TBS & Jointing added	EL	10/11/25
AB17	Plot 52-55,6xSL added	VK	14/10/25
AB16	Plot 37-38,41-42 added	VK	24/09/25
AB15	Mains added	VK	17/09/25
AB14	Plot 32-33,36 added	VK	11/08/25
AB13	Plot 39-40 added	VK	01/08/25
AB11	Plot 34-35, Pumping Station added	VK	17/07/25
AB10	4xSL added	VK	17/06/25
AB9	Plots 18-23 tested and jointing added	EL	03/06/25
AB8	Mains added	EL	29/05/25

FULCRUM
2 Europa View
Sheffield Business Park
Sheffield
S9 1XH

Drawing Number:	5105411-E-Hollingworth Road-Aslaid Cable Route- Rev. AB25
Drawing Title:	Aslaid Cable Route
Site Address:	Hollingworth Road Littleborough OL15 0AU
OS Grid Reference:	393687 ; 041604
Project Number:	5105411
DNO Reference Number:	-
IDNO Reference Number:	ESPE035354
Scale:	1:500
Sheet Size:	A0